


MICROFILMED

HOUSTON STREET
WATER & SEWER IN STRAY

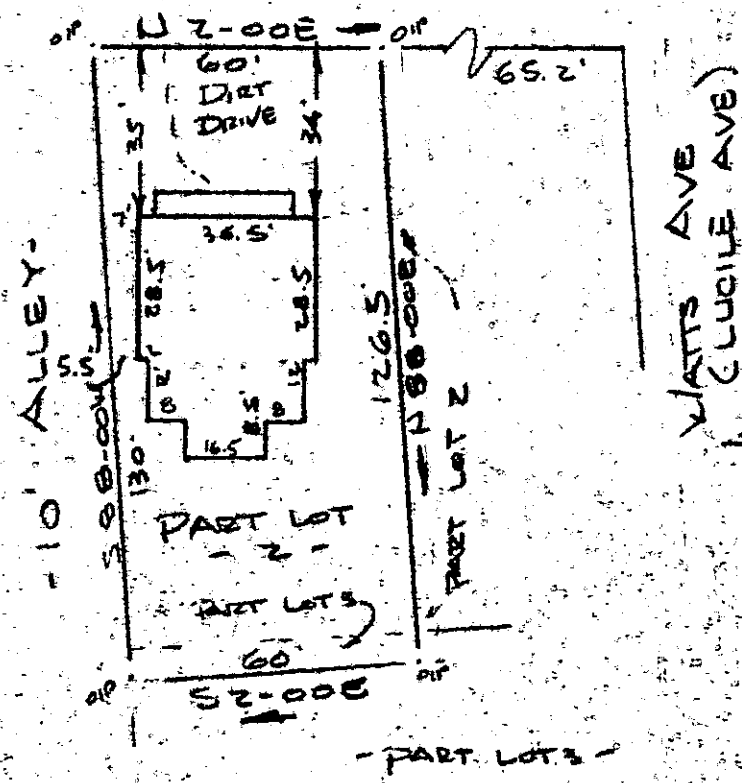


Notes:
Improvements
on this lot
are not in a
flood hazard
area.

FILED
GREENVILLE, S.C.
AUG 1 3 25 PM '84
DONNIE S. ALFORD, R.P.C.

PROPERTY OF
HERBERT E. RIDGLE, JR.
GREENVILLE, S.C.

SCALE: 1" = 40' 30 JULY 1984

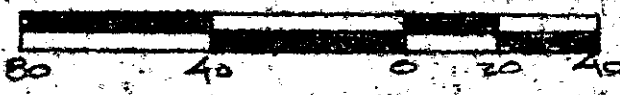

This is to certify that on the 30th day of July, 1984, I surveyed the property shown on this plat, being known as part of lot 2 and part of lot 1 on plat of BLOCK "J" PROPERTY OF WATSON SPRING LAGOON CO., and recorded in the REC OFFICE Greenville County, S. C., in Plat Book "A" at Page 41 and also being known as PROPERTY OF HERBERT E. RIDGLE, JR. and recorded in Plat Book _____ at Page _____; and that the property lines, walls and buildings are as shown hereon, and that the walls and buildings located on said lot do not encroach or project on adjacent street or property, and that no adjacent walls or buildings encroach or project on said premises, and no power lines cross this property except as shown hereon.

10-V-73

3588

R. B. Bruce
E. B. Bruce, R.P.C. 1984

CAROLINA SURVEYING CO.
112 Marly St.
Greenville, S. C.

Recordable Plat

3003 TIAOTI