MICROFILMED

FILED
GREENVILLE CO. SC
AUG 20 2 29 PM '84
DONNIE S. TANKERSLEY
R.H.C.

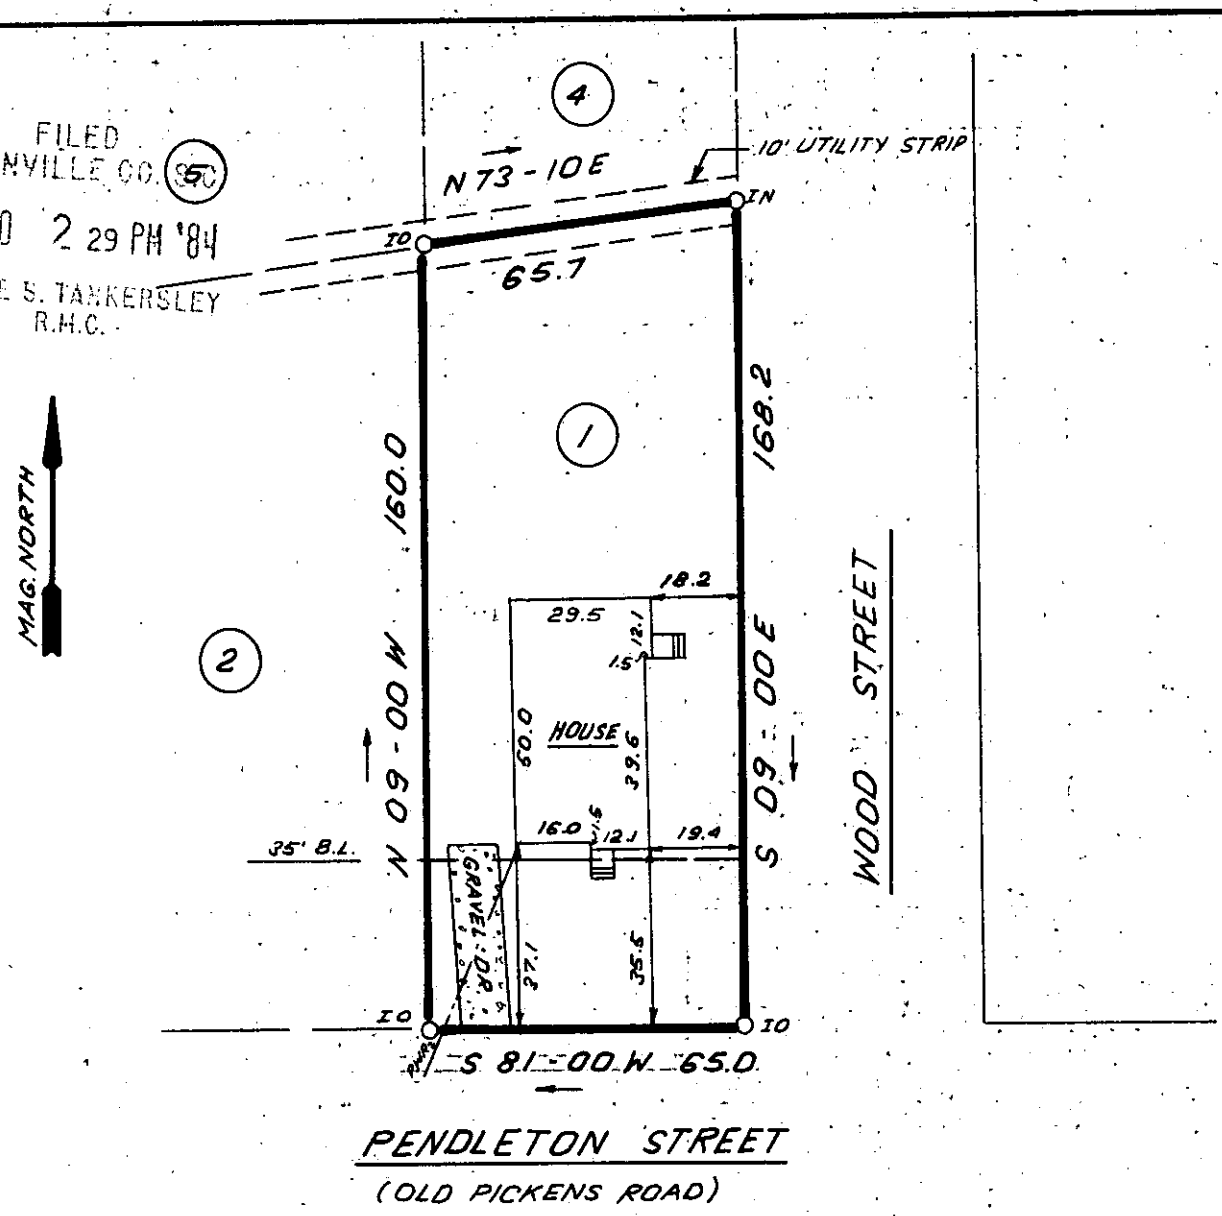

40 0 40 80
SCALE: 1" = 40' FEET

5433 10-W AUG 29 AUG 20 1984

THIS IS TO CERTIFY THAT THE PROPERTY SHOWN ON THIS PLAT WAS SURVEYED UNDER MY DIRECT SUPERVISION. PROPERTY LINES AND IMPROVEMENTS SHOWN ARE LOCATED CORRECTLY AND THAT NO VISIBLE ENCROACHMENTS EXIST UNLESS OTHERWISE SHOWN. THIS PROPERTY IS NOT LOCATED IN A DESIGNATED FLOOD HAZARD AREA.

SOUTH CAROLINA LAND SURVEYOR 4781 REGISTERED JAMES R. FREELAND

REG. NO. 4781

STATE OF SOUTH CAROLINA
GREENVILLE COUNTY

WOODVILLE HEIGHTS
SEC. B ; LOT 1
PROPERTY OF
JAMES R. CLARDY SR.
MARK K. STEWART

FREELAND & ASSOCIATES
Engineers • Land Surveyors
318 WEST STONE AVENUE.
GREENVILLE, S.C.
(803) 271-4924

PLAT BOOK	L-14,15/K-272-275
DEED BOOK	1208-384
TAX MAP	234-1-13
PARTY CHIEF	J.E.C.
DRAWN	I.R.
DATE	8-7-84
DWG. NO.	11593

THE PRINT MACHINE, INC. N37703