MICROFILMED

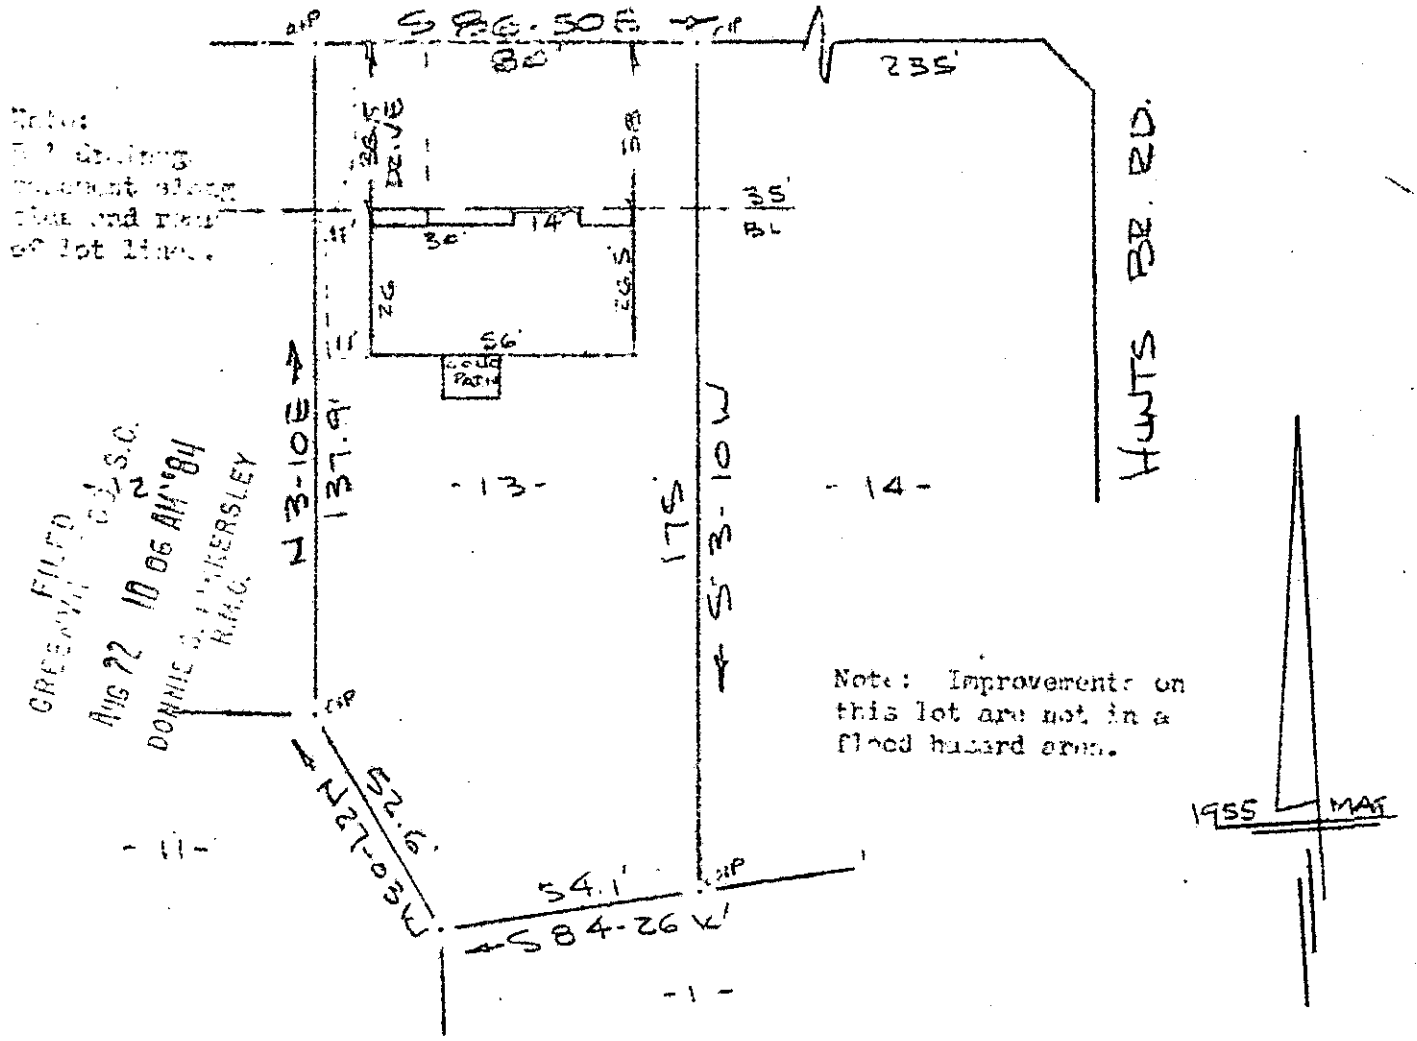

PROPERTY OF
WILLIAM H. McCAULEY & LESLIE A. McCAULEY
NEAR GREENVILLE, S. C.
SCALE: 1" = 40' 20 AUG 1984

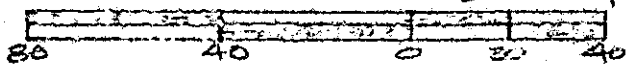

This is to certify that on the 20th day of August, 1984, I surveyed the property shown on this plat, being known as lot 13 on plat of BLUE BERRY PARK and recorded in the RMC Office Greenville County, S. C., in Plat Book " BB " at Page 18; and that the property lines, walls and buildings are as shown hereon, and that the walls and buildings located on said lot do not encroach or project on adjacent street or property, and that no adjacent walls or buildings encroach or project on said premises, and no power lines cross this property except as shown hereon.

10-W-41

R. B. Bruce

R. B. Bruce, RLS #1655

AUG 22 1984

CAROLINA SURVEYING CO.
112 Manly St.
Greenville, S. C.

5660

Recordable Plat

(10083)

BOOK 1508 PAGE 1 AUG 22 84