
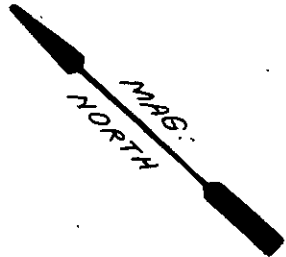


FILED
GREENVILLE CO. S.C.
SEP 7 3 18 PM '84
DONNIE E. JANKERSLEY
R.M.C.

S 41-46 E

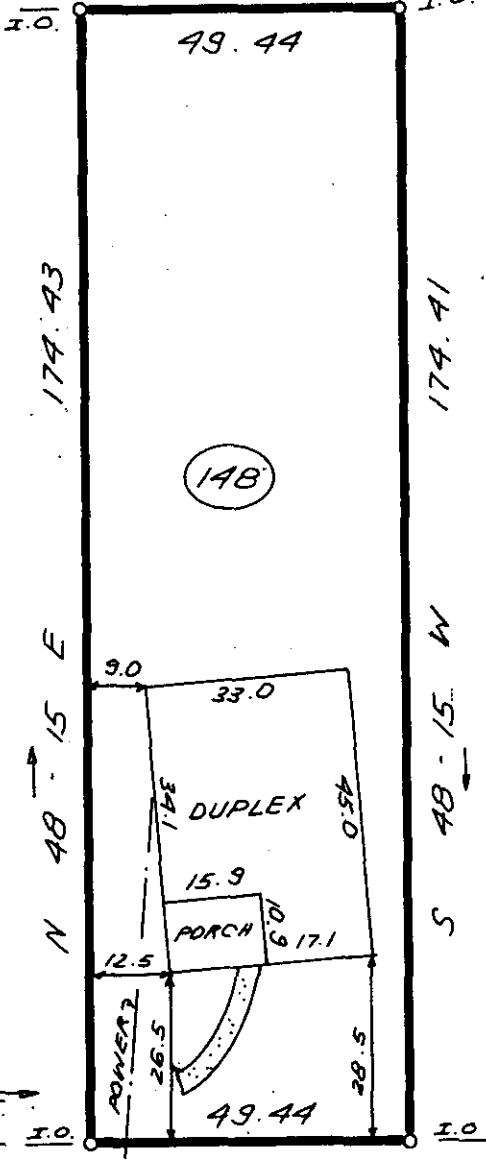

147


148

1

T.M. 66-3-14

350' ± TO
BOYCE SPRINGS AVE.

N 41-48 W
CLEVEIRVINE AVE.

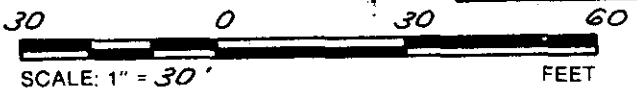

7678
10-X-2
SEP 7 1984

THIS IS TO CERTIFY THAT THE PROPERTY SHOWN ON THIS PLAT WAS SURVEYED UNDER MY DIRECT SUPERVISION. PROPERTY LINES AND IMPROVEMENTS SHOWN ARE LOCATED CORRECTLY AND THAT NO VISIBLE ENCROACHMENTS EXIST UNLESS OTHERWISE SHOWN. THIS PROPERTY IS NOT LOCATED IN A DESIGNATED FLOOD HAZARD AREA.

STATE OF SOUTH CAROLINA
GREENVILLE COUNTY

FREELAND & ASSOCIATES
Engineers • Land Surveyors
318 WEST STONE AVENUE.
GREENVILLE, S.C.
(803) 271-4924

EAST PARK
BOYCE LAWN ADDITION
LOT 148
PROPERTY OF
MICHAEL G. BURTON, SR.

PLAT BOOK	A @ 383
DEED BOOK	
TAX MAP	66-3-13
PARTY CHIEF	J.E.C.
DRAWN	K.E.G.
DATE	SEPT. 5, 1984
DWG. NO.	11721-C

SOUTH CAROLINA
REGISTERED LAND SURVEYOR
4781
JAMES P. FREELAND
R.L.S. JAMES P. FREELAND
NO: 4781

3.00CT
1 SEPT 84 1358