

FILED  
 GREENVILLE CO. S.C.  
 SEP 11 10 37 AM '84  
 DUNNIE S. JAMBERSLEY  
 R.M.C.


SWINDON CIRCLE

NOTE: 5' UTILITY & DRAINAGE  
 EASEMENT EACH SIDE OF ALL  
 SIDE & REAR LOT LINES.



7944  
 10-Y-5

THIS IS TO CERTIFY THAT THE PROPERTY SHOWN ON THIS PLAT WAS SURVEYED UNDER MY DIRECT SUPERVISION. PROPERTY LINES AND IMPROVEMENTS SHOWN ARE LOCATED CORRECTLY AND THAT NO VISIBLE ENCROACHMENTS EXIST UNLESS OTHERWISE SHOWN. THIS PROPERTY IS NOT LOCATED IN A DESIGNATED FLOOD HAZARD AREA.

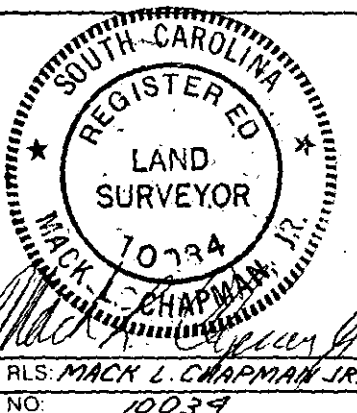

**STATE OF SOUTH CAROLINA  
 GREENVILLE COUNTY**

KINGSGATE  
SEC. 2 ; LOT 136  
PROPERTY OF  
GRADY I. SHEALY  
EUGENIA P. SHEALY &

**FREELAND & ASSOCIATES**  
 Engineers • Land Surveyors  
 318 WEST STONE AVENUE.  
 GREENVILLE, S.C.  
 (803) 271-4924

PLAT BOOK	50 @ 23
DEED BOOK	
TAX MAP	591.5-1-123
PARTY CHIEF	M.L.C.
DRAWN	K.E.G.
DATE	SEPT. 7, 1984
DWG. NO.	11730

1509  
 184  
 7  
 84  
 1509