



This is to certify that on August 17, 1984, I surveyed the property shown on this plat, known as Property of Eugenia A.K. Manos,, recorded in the RMC Office of Greenville County in Deed Book 245 on page 362,, and that the property lines, walls and buildings are as shown hereon; that the building located on said property does not encroach or project on adjacent streets, property,, and that no adjacent walls or buildings encroach or project on said premises; and that no utility lines cross this property except as shown hereon. This property is not located in a designated flood hazard area.

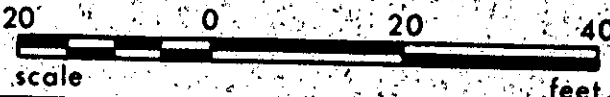

*James R. Freeland*  
 James R. Freeland RLS & PE 4781

PRINT MACHINE, INC.

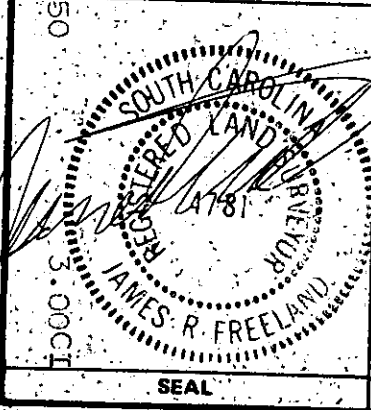

**STATE OF SOUTH CAROLINA  
 GREENVILLE COUNTY**

PROPERTY OF  
WILLIAM J. BOUHARON  
PATRICIA H. BOUHARON

FREELAND & ASSOCIATES Engineers • Land Surveyors	
GREENVILLE, S.C.	
SURVEY	DCH & LT
DRAWN	BR
CHECK	MLC
SCALE	1" = 20'
DATE	AUG. 17, 84
DWG. NO.	6607-A