
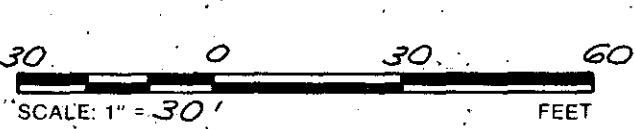


FILED  
GREENVILLE CO. S.C.  
SEP 17 3 28 PM '84  
DONNIE S. TAMKERSLEY  
R.M.C.

(2)

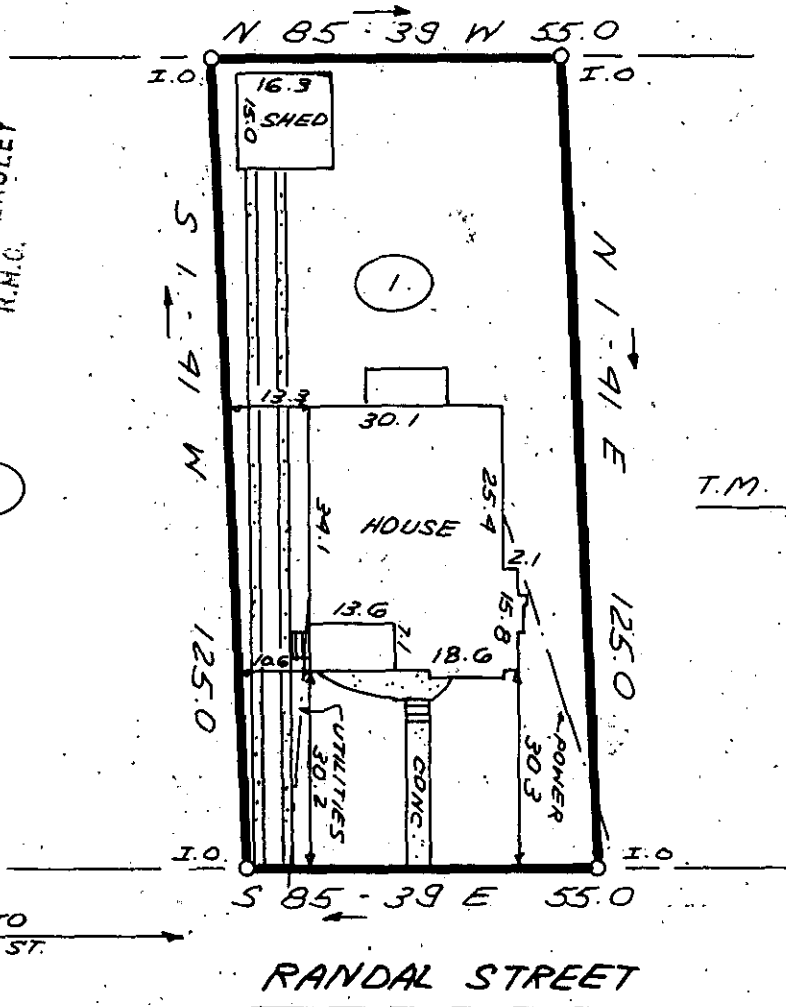

SEP 17 1984  
10-4-24

THIS IS TO CERTIFY THAT THE PROPERTY SHOWN ON THIS PLAT WAS SURVEYED UNDER MY DIRECT SUPERVISION. PROPERTY LINES AND IMPROVEMENTS SHOWN ARE LOCATED CORRECTLY AND THAT NO VISIBLE ENCROACHMENTS EXIST UNLESS OTHERWISE SHOWN. THIS PROPERTY IS NOT LOCATED IN A DESIGNATED FLOOD HAZARD AREA.

**SOUTH CAROLINA REGISTERED LAND SURVEYOR**  
JAMES R. FREELAND  
No. 4281

**STATE OF SOUTH CAROLINA  
GREENVILLE COUNTY**

PROPERTY OF  
**ROBERT E. URIE**

<b>FREELAND &amp; ASSOCIATES</b> Engineers • Land Surveyors 318 WEST STONE AVENUE, GREENVILLE, S.C. (803) 271-4924	
PLAT-BOOK	H @ 65
DEED BOOK	
TAX MAP	7-4-5.1
PARTY CHIEF	L.T.
DRAWN	K.E.G.
DATE	SEPT. 12, 1984
DWG. NO.	1173-3000