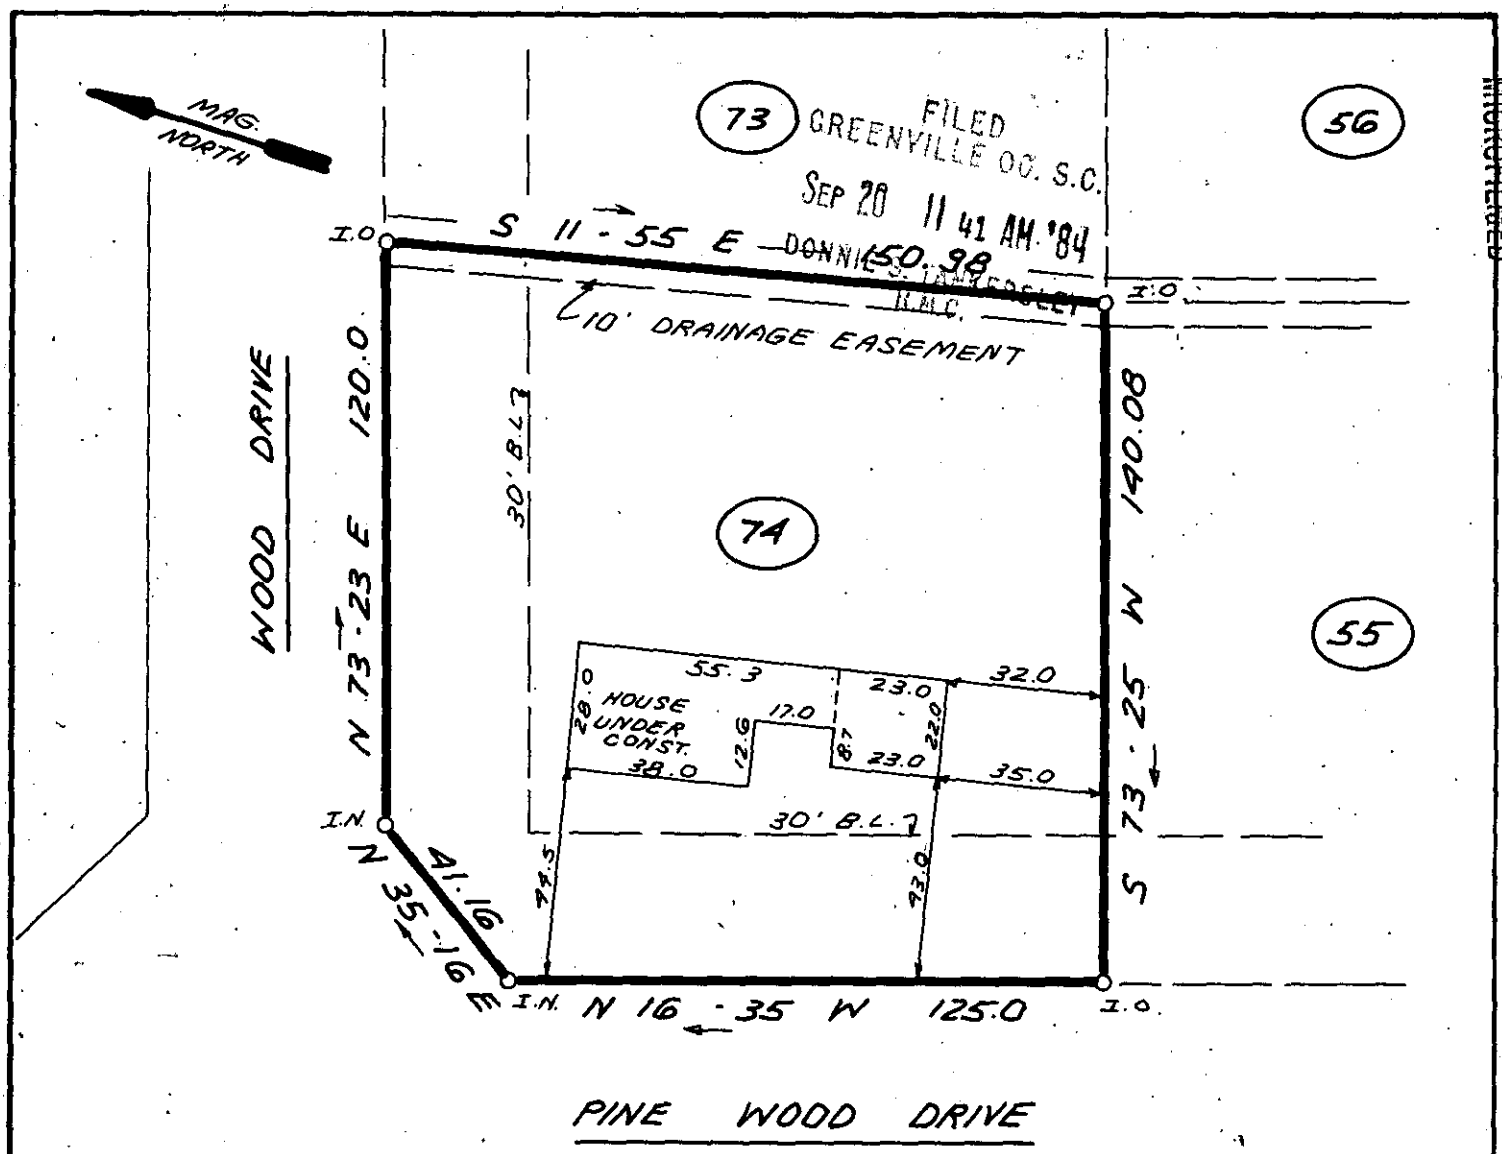

10-Y-32 8937 ✓

NOTE: THERE IS A 5' DRAINAGE & UTILITIES EASEMENT ALONG EACH SIDE OF ALL SIDE & REAR LOT LINES.

40 0 40 80

SCALE: 1" = 40' FEET

SEP 20 1984

THIS IS TO CERTIFY THAT THE PROPERTY SHOWN ON THIS PLAT WAS SURVEYED UNDER MY DIRECT SUPERVISION. PROPERTY LINES AND IMPROVEMENTS SHOWN ARE LOCATED CORRECTLY AND THAT NO VISIBLE ENCROACHMENTS EXIST UNLESS OTHERWISE SHOWN. THIS PROPERTY IS NOT LOCATED IN A DESIGNATED FLOOD HAZARD AREA.

SOUTH CAROLINA REGISTERED LAND SURVEYOR 4781 JAMES R. FREELAND

RLS: JAMES R. FREELAND
NO: 4781

STATE OF SOUTH CAROLINA
GREENVILLE COUNTY

PINE BROOK FOREST
SEC. 1 ; LOT 74
PROPERTY OF
WILLIAM P. VAUGHN, JR.
&
CAROLYN MARIE VAUGHN

FREELAND & ASSOCIATES
Engineers • Land Surveyors
318 WEST STONE AVENUE.
GREENVILLE, S.C.
(803) 271-4924

PLAT BOOK	4X @ 48 & 49
DEED BOOK	
TAX MAP	574.11-1-74
PARTY CHIEF	R.J. & L.T.
DRAWN	K.E.G.
DATE	SEPT. 11, 1984
DWG. NO.	11745

MICROFILMED
SEP 20 1984 755
3.00CT
THE PRINT MACHINE, INC. N37703