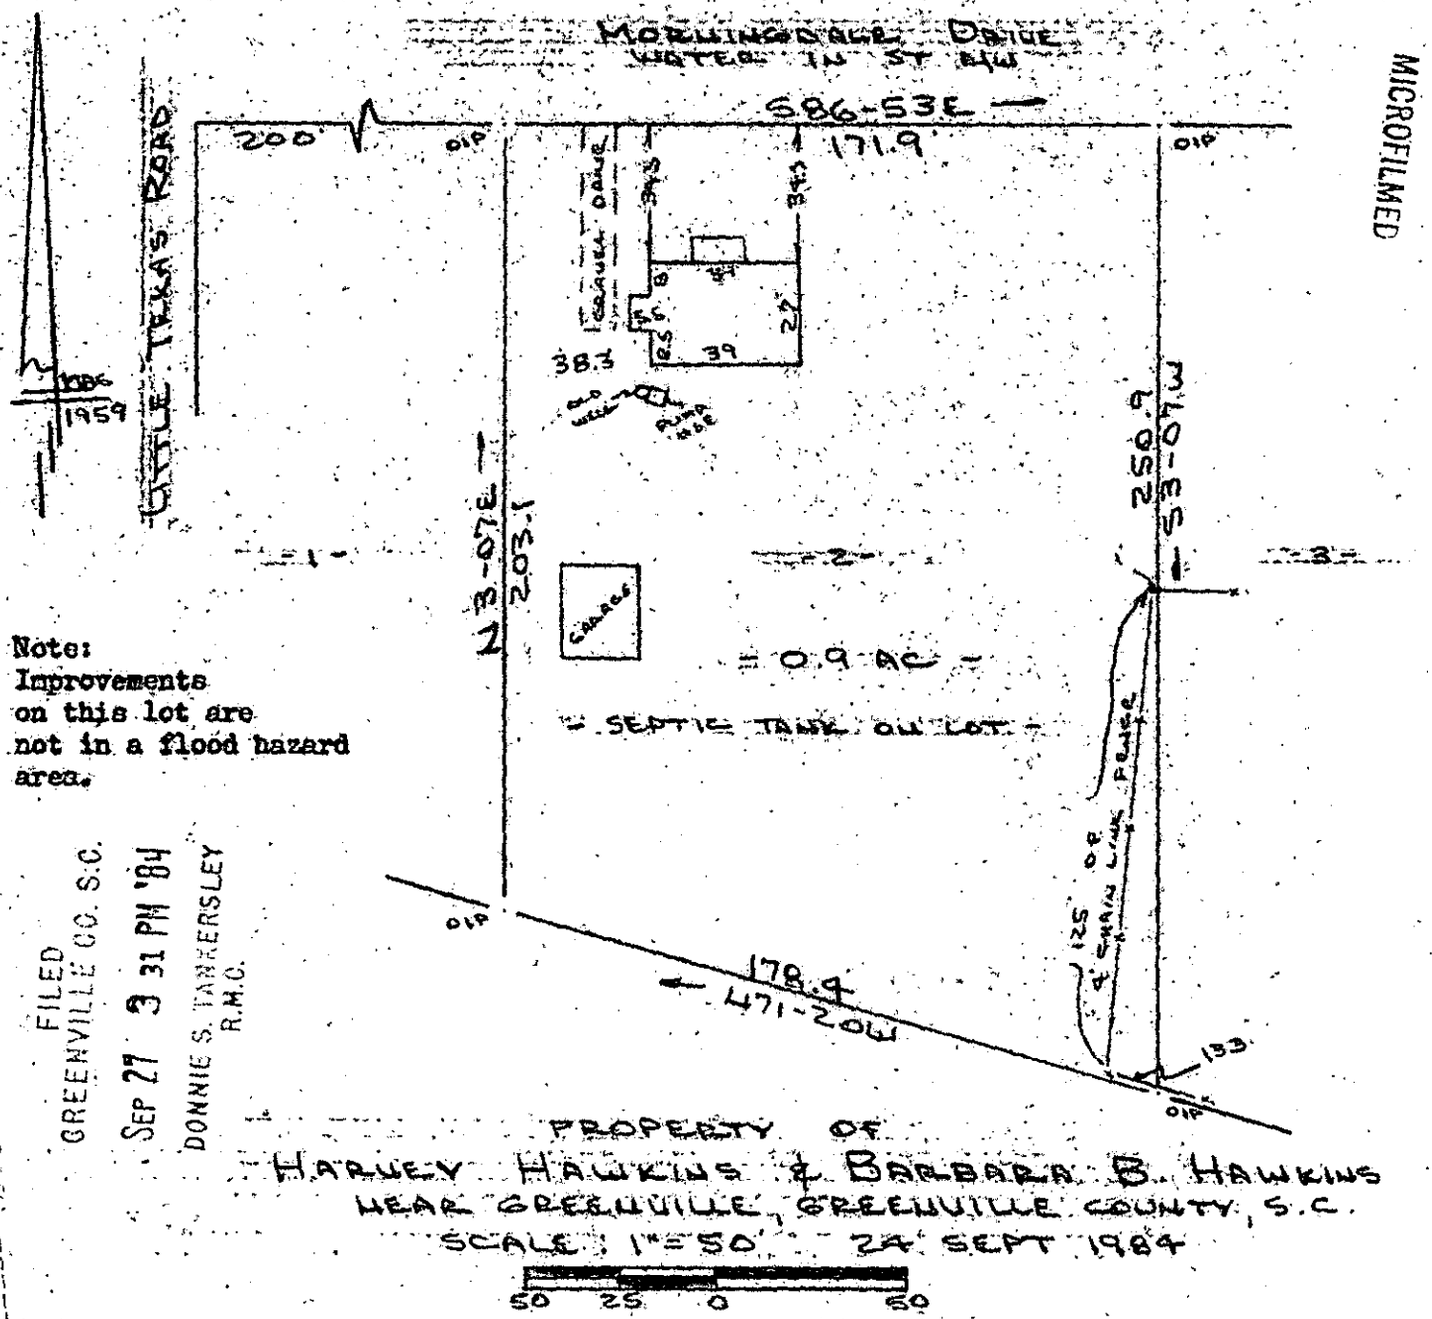

Note:
Improvements
on this lot are
not in a flood hazard
area.

FILED
GREENVILLE CO. S.C.
SEP 27 3 31 PM '84
DONNIE S. TANKERSLEY
R.M.C.

PROPERTY OF
HARVEY HAWKINS & BARBARA B. HAWKINS
NEAR GREENVILLE, GREENVILLE COUNTY, S.C.
SCALE: 1"=50' 24 SEPT 1984

This is to certify that on the 24th day of September, 1984, I surveyed the property shown on this plat, being known as lot 2 on plat of MOUNTAIN VIEW ACRES and recorded in the RMC Office Greenville County, S. C., in Plat Book " TT " at Page 3 and also being known as PROPERTY OF HARVEY HAWKINS & BARBARA B. HAWKINS and recorded in Plat Book at Page ; and that the property lines, walls and buildings are as shown hereon, and that the walls and buildings located on said lot do not encroach or project on adjacent street or property, and that no adjacent walls or buildings encroach or project on said premises, and no power lines cross this property except as shown hereon.

10-X-50

9645

R. B. Bruce, RLS # 1952

CAROLINA SURVEYING CO.
112 Manly St.
Greenville, S. C.

Recordable Plat

3.00CI

277/22

5po.3-1-28.2