
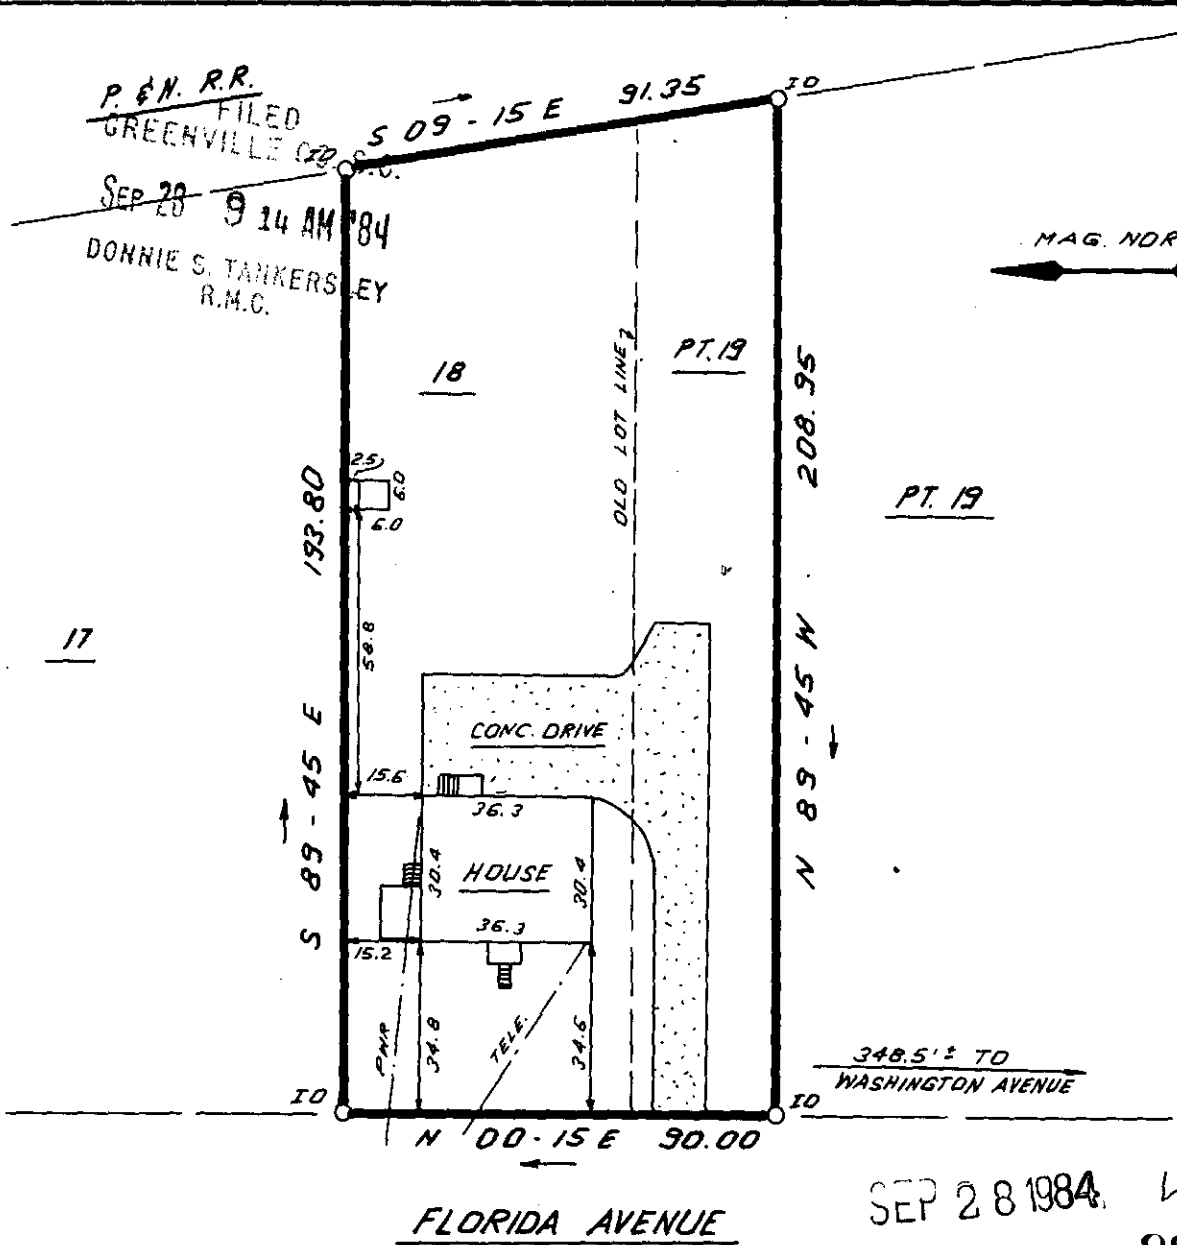


MICROFILMED

P. & N. R.R.  
FILED  
GREENVILLE CO.

SEP 28 9 14 AM '84


DONNIE S. TANKERSLEY  
R.M.C.

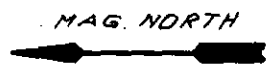

SEP 28 1984 ✓

9863

10-1-51

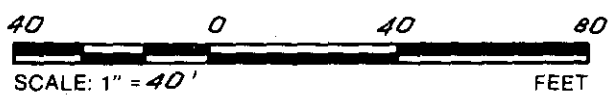

THIS IS TO CERTIFY THAT THE PROPERTY SHOWN ON THIS PLAT WAS SURVEYED UNDER MY DIRECT SUPERVISION. PROPERTY LINES AND IMPROVEMENTS SHOWN ARE LOCATED CORRECTLY AND THAT NO VISIBLE ENCROACHMENTS EXIST UNLESS OTHERWISE SHOWN. THIS PROPERTY IS NOT LOCATED IN A DESIGNATED FLOOD HAZARD AREA.

**STATE OF SOUTH CAROLINA  
GREENVILLE COUNTY**

**FRELAND & ASSOCIATES**  
Engineers • Land Surveyors  
318 WEST STONE AVENUE.  
GREENVILLE, S.C.  
(803) 271-4924

HIGHLAND  
LOT 18 & PT. LOT 19  
PROPERTY OF  
KENNETH W. GIBBS  
DINA J. GIBBS

PLAT BOOK	K-50-51
DEED BOOK	1136-351
TAX MAP	227-3-18
PARTY CHIEF	R.A.J
DRAWN	I.R.
DATE	9-25-84
DWG. NO.	11813

300  
3  
31A01