



FILED
 GREENVILLE CO. S.C.
 OCT 9 12 04 PM '84
 DONNIE S. TANKERSLEY
 R.M.C.

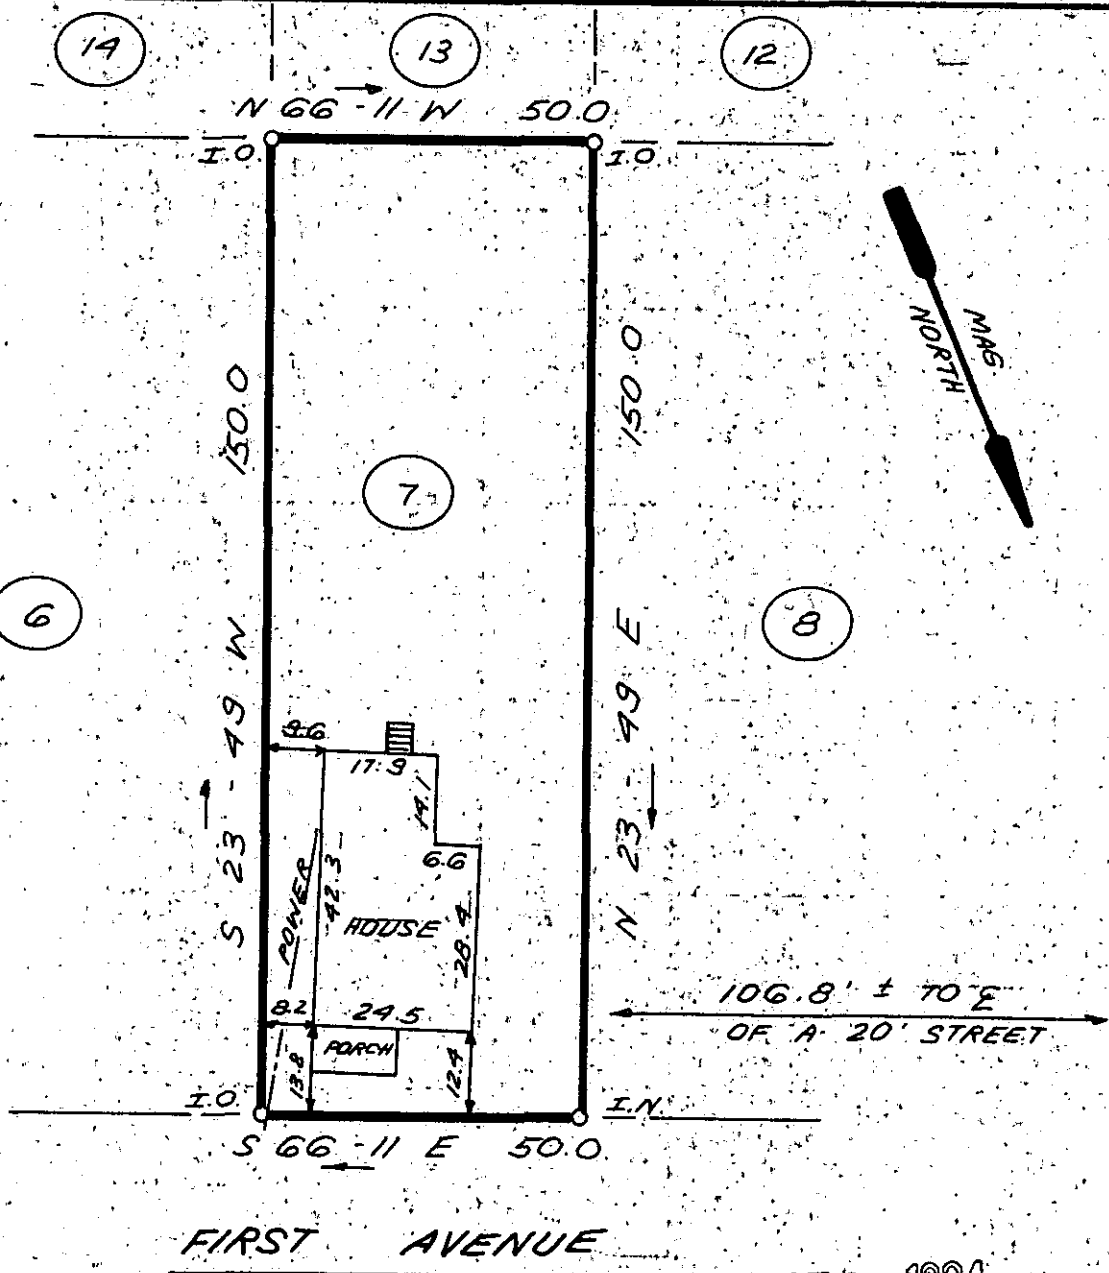

FIRST AVENUE

OCT 9 1984

10-4-59 ✓ 10799

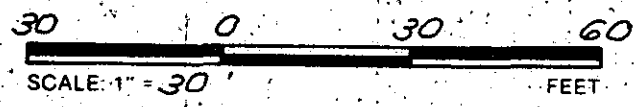


THIS IS TO CERTIFY THAT THE PROPERTY SHOWN ON THIS PLAT WAS SURVEYED UNDER MY DIRECT SUPERVISION. PROPERTY LINES AND IMPROVEMENTS SHOWN ARE LOCATED CORRECTLY AND THAT NO VISIBLE ENCROACHMENTS EXIST UNLESS OTHERWISE SHOWN. THIS PROPERTY IS NOT LOCATED IN A DESIGNATED FLOOD HAZARD AREA.

STATE OF SOUTH CAROLINA
 GREENVILLE COUNTY

FREELAND & ASSOCIATES
 Engineers • Land Surveyors
 318 WEST STONE AVENUE.
 GREENVILLE, S.C.
 (803) 271-4924

SUNNY SLOPE
BLOCK D, LOT 7
PROPERTY OF
G. STEVE MERRITT

PLAT BOOK	F-86
DEED BOOK	1179-766
TAX MAP	135-7-3
PARTY CHIEF	R.A.J.
DRAWN	K.E.G.
DATE	SEPT. 26, 1984
DWG. NO.	11813

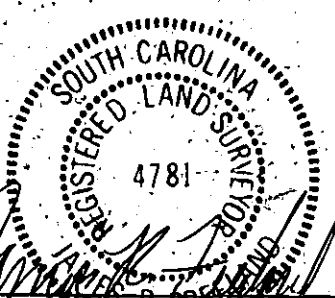

RLS: JAMES R. FREELAND
 NO. 4781

200-924 718