


FILED
GREENVILLE, CO. S.C.

OCT 18 4:17 PM '84

DOMNIE'S TANKERSLEY
R.M.C.


BROUGHTON DRIVE
WATER & SEWER IN ST. R.W.

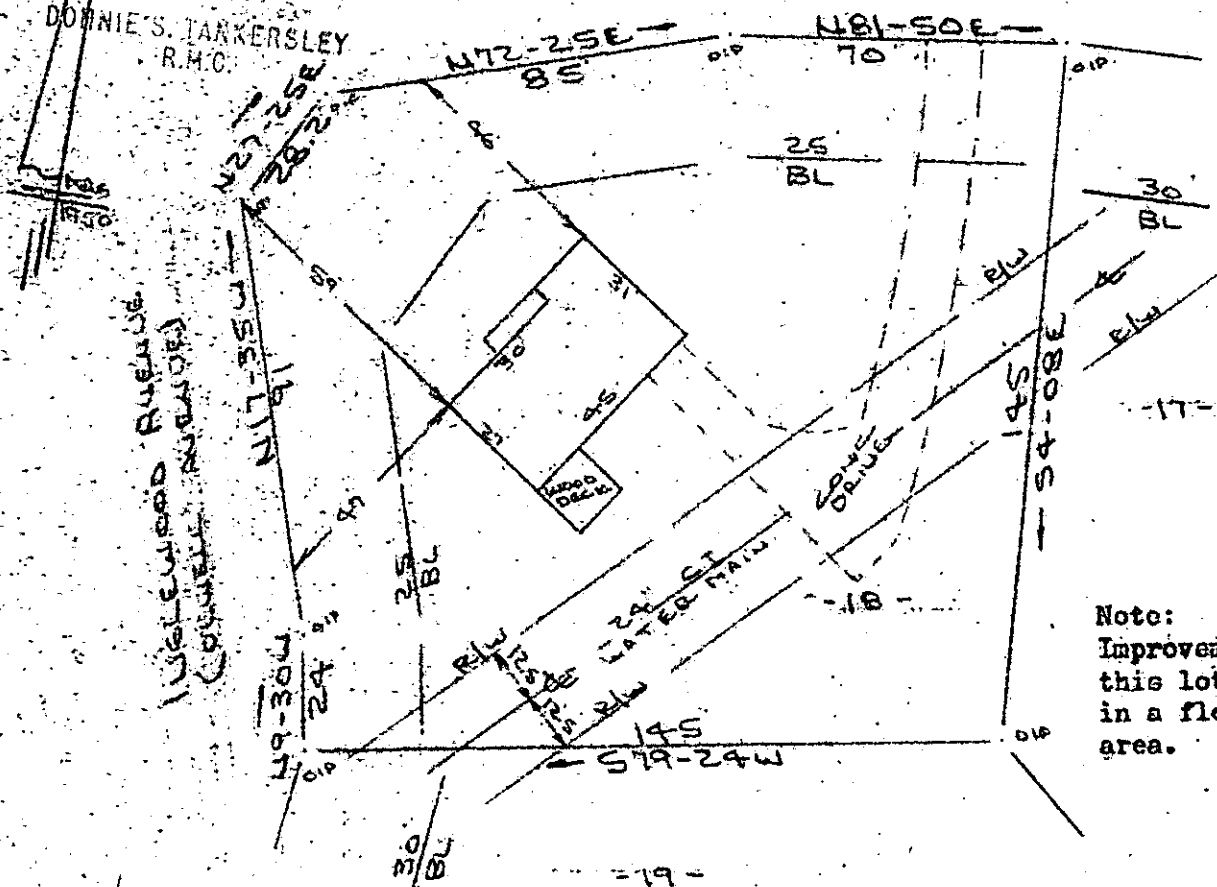

Note:
Improvements on
this lot are not
in a flood hazard
area.

PROPERTY OF
WILLIAM G. BAGGOTT & TERESA J. BAGGOTT

GREENVILLE, S.C.
SCALE: 1"=40' 5 OCT 1984

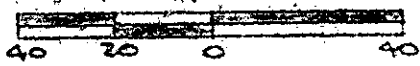

This is to certify that on the 5th day of October, 1984, I surveyed the property shown on this plat, being known as lot 18 SECTION "G" on plat of A REVISION OF CROFTSTONES ACRES and recorded in the RMC Office Greenville County, S. C., in Plat Book "Y" at Page 91; and that the property lines, walls and buildings are as shown hereon, and that the walls and buildings located on said lot do not encroach or project on adjacent street or property, and that no adjacent walls or buildings encroach or project on said premises, and no power lines cross this property except as shown hereon.

11-A-21

11837

R. B. Bruce
 R. B. Bruce, RLS # 1952
 Recordable Plat

OCT 18 1984

CAROLINA SURVEYING CO.
112 Manly St.
Greenville, S. C.

1984