

FILED  
GREENVILLE CO., S.C.

OCT 19 9 46 AM '84

DONNIE S. TANKERSLEY  
R.M.C.

MAB  
1983

WALKER WAY  
WATER & SEWER IN STR

- PT 38 -

- PT 38 -

- 37 -


- 26 -

- 25 -

Note:  
Improvements on this lot  
are not in a flood hazard  
area.

PROPERTY OF  
TOMMY D. ABBOTT JR

NEAR GREENVILLE,  
GREENVILLE COUNTY, S.C.  
SCALE: 1" = 40' 11 OCT 1984

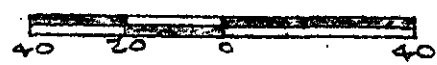

This is to certify that on the 11th day of October, I surveyed the property shown on this plat, being known as lot 37 and part of lot 38 on plat of WALKERS CROSSING and recorded in the RMC Office Greenville County, S. C., in Plat Book " 10 - M " at Page 2 also shown on an unrecorded plat by JAMES E. FREELAND, NO. 4781 shown as WALKER ESTATES dated October 10, 1984 and also shown as PROPERTY OF TOMMY D. ABBOTT, JR. and recorded in the RMC Office in Plat Book at Page and that the property lines, walls and buildings are as shown hereon, and that the walls and buildings located on said lot do not encroach or project on adjacent street or property, and that no adjacent walls or buildings encroach or project on said premises, and no power lines cross this property except as shown hereon.

11-A-22

11963

CAROLINA SURVEYING CO.  
112 Manly St.  
Greenville, S. C.

R. B. Bruce  
R.M.C. # 1952

Recordable Plat

GC10 ----- 1 OCT 22 84

067

3.00CD