
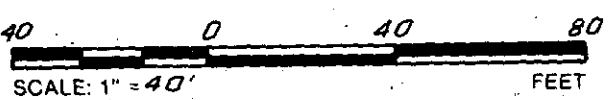


FILED  
GREENVILLE CO. S.C.  
OCT 19 10 49 AM '84  
DONNIE S. TANKERSLEY  
R.M.C.

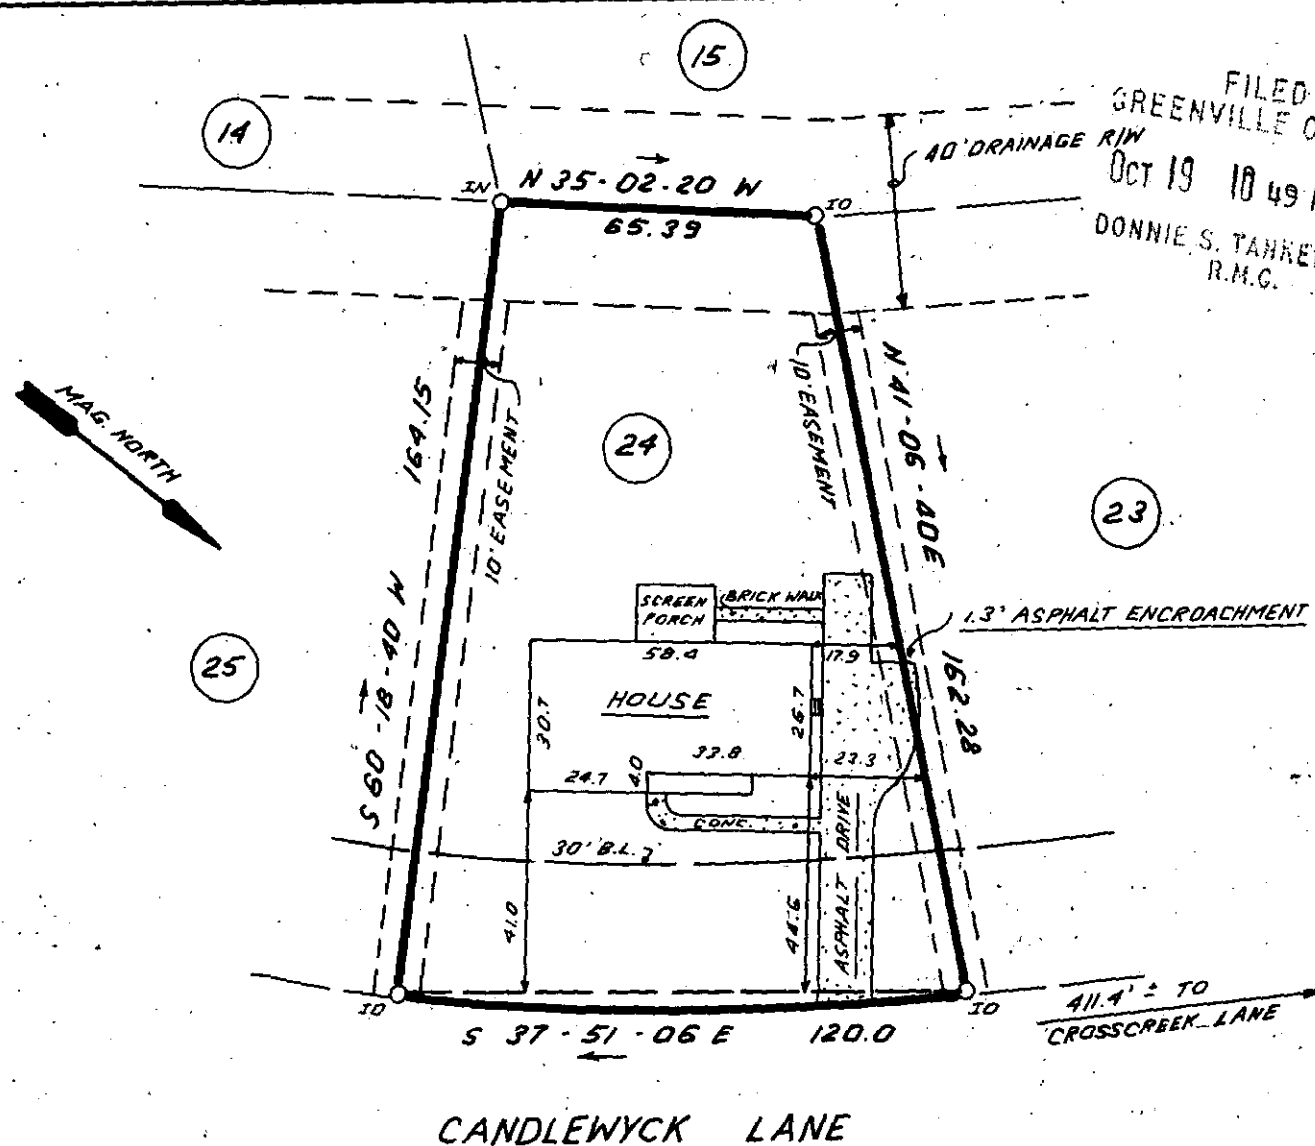

11862  
11A-26

OCT 19 1984

APPLE TREE  
COURT

THIS IS TO CERTIFY THAT THE PROPERTY SHOWN ON THIS PLAT WAS SURVEYED UNDER MY DIRECT SUPERVISION. PROPERTY LINES AND IMPROVEMENTS SHOWN ARE LOCATED CORRECTLY AND THAT NO VISIBLE ENCROACHMENTS EXIST UNLESS OTHERWISE SHOWN. THIS PROPERTY IS NOT LOCATED IN A DESIGNATED FLOOD HAZARD AREA.

300  
1A01

**SOUTH CAROLINA**  
REGISTERED LAND SURVEYOR  
4781  
JAMES R. FREELAND  
RLS: JAMES R. FREELAND  
NO: 4781

**STATE OF SOUTH CAROLINA  
GREENVILLE COUNTY**

MOUNTAINBROOKE  
LOT 24  
PROPERTY OF  
MICHAEL C. KEENEY  
JENNIFER L. KEENEY

**FREELAND & ASSOCIATES**  
Engineers • Land Surveyors  
318 WEST STONE AVENUE.  
GREENVILLE, S.C.  
(803) 271-4924

PLAT BOOK	4F-47
DEED BOOK	1040-621
TAX MAP	540.8-1-24
PARTY CHIEF	J.C.
DRAWN	I.R.
DATE	9-26-84
DWG. NO.	11819