


FILED
GREENVILLE CO. S.C.
Mag.
OCT 24 11-28 AM '84
DONNIE S. TANKERSLEY
R.M.C.

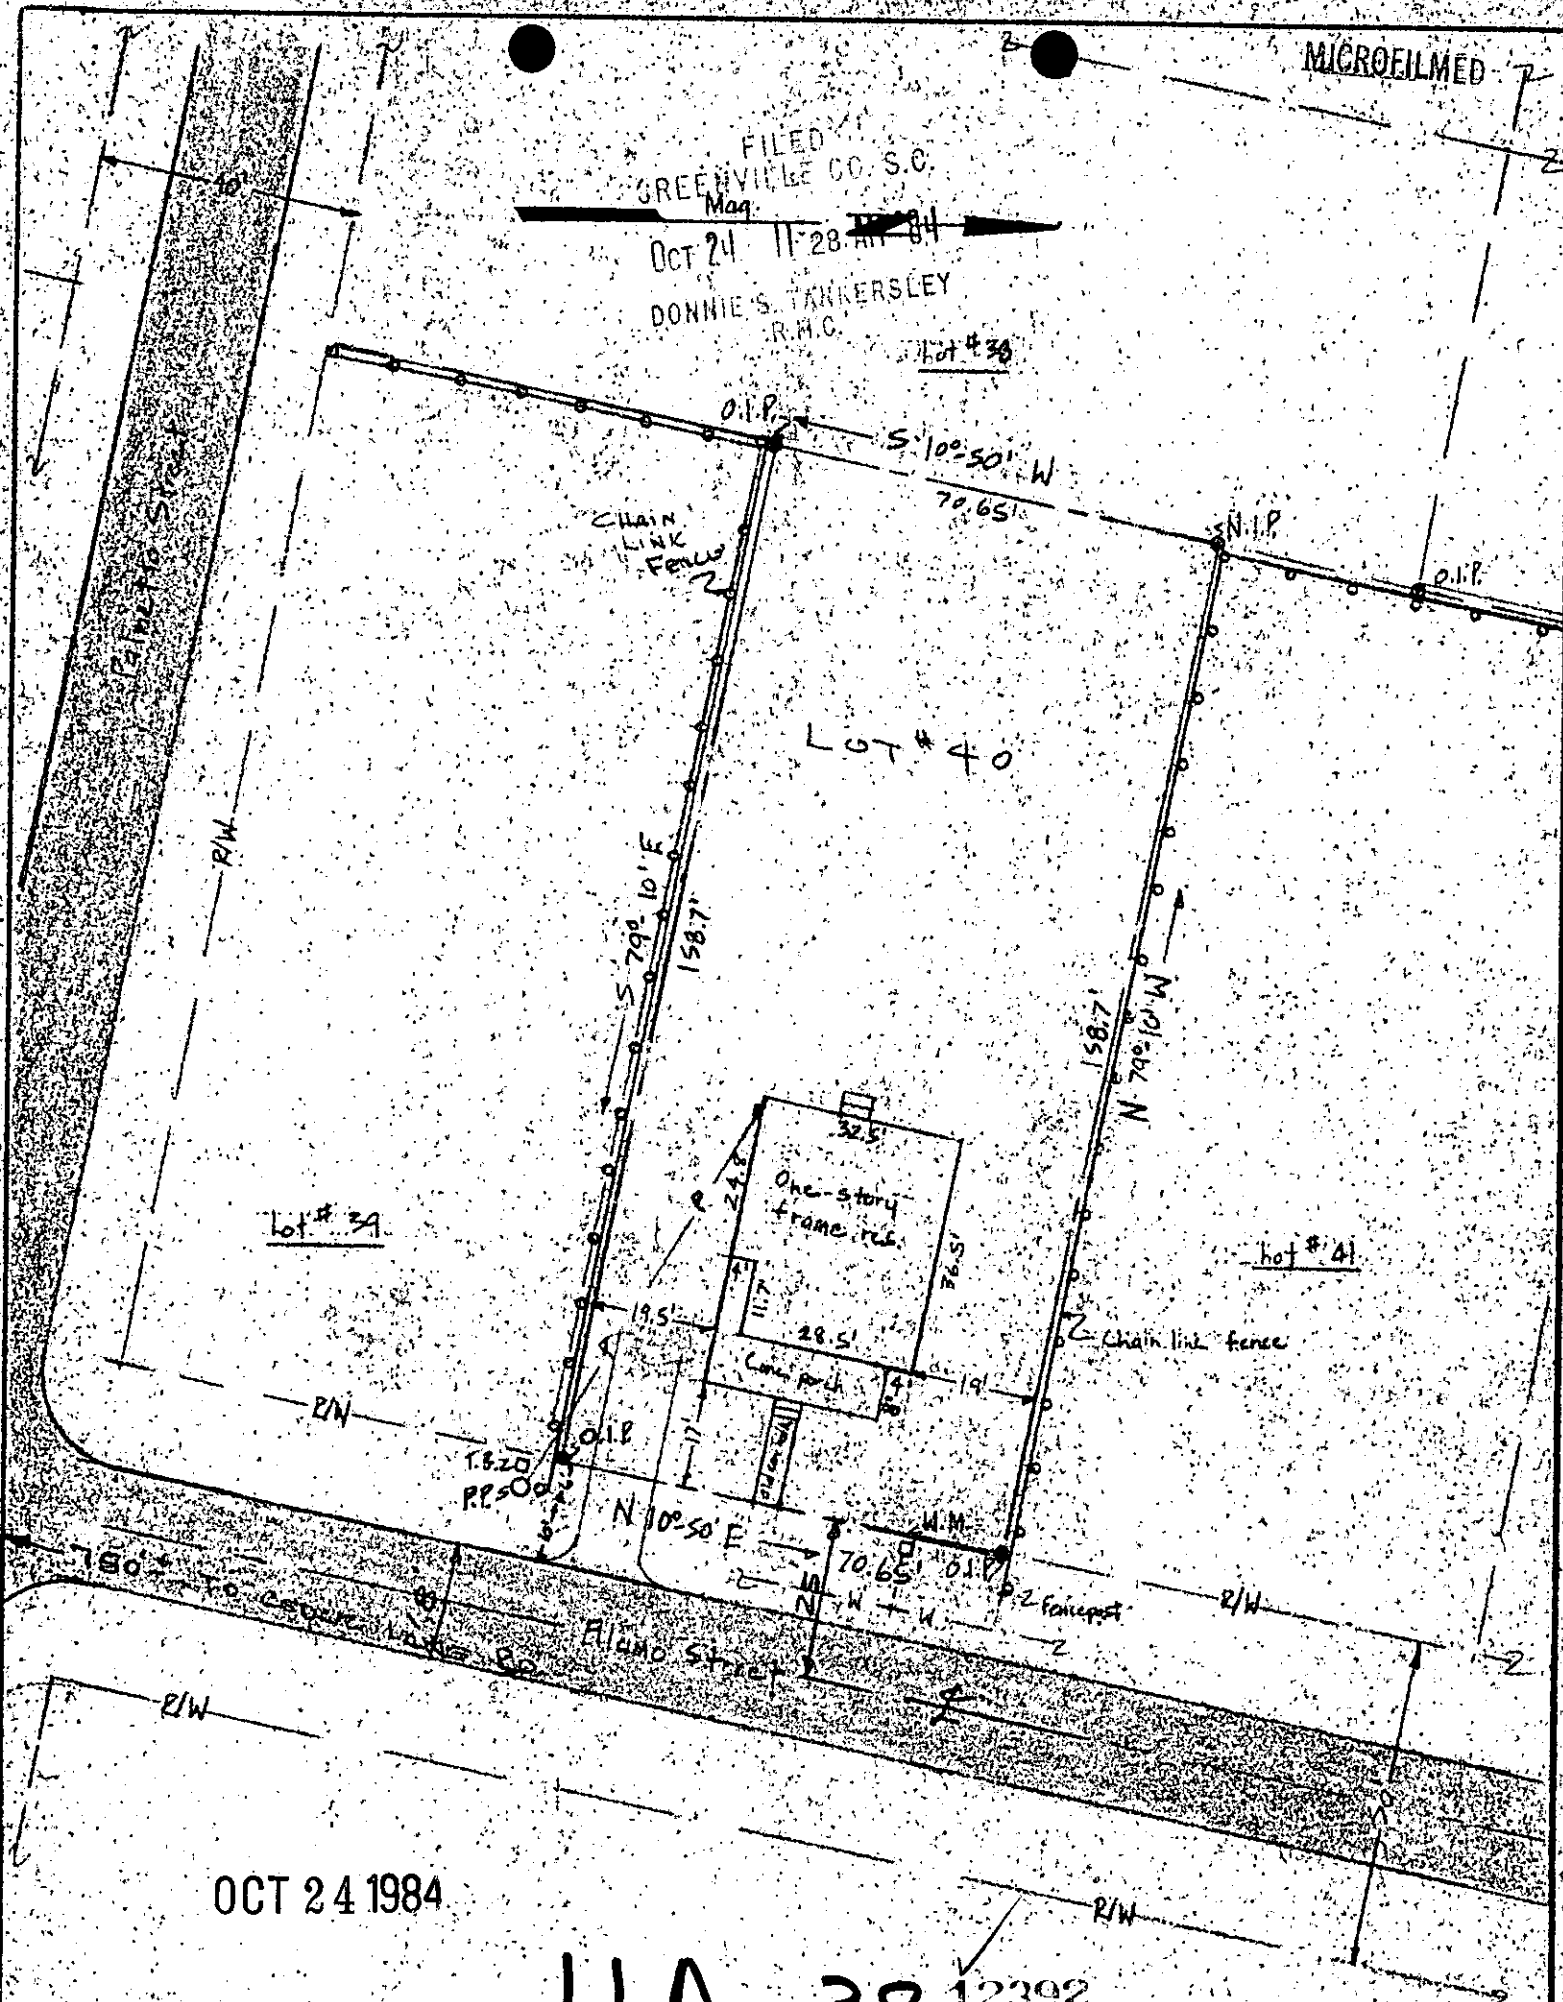

OCT 24 1984

11A-38 12392

I certify that I have surveyed this lot and that it is, to the best of my knowledge, as shown, that there are no encroachments unless otherwise shown, and that, unless indicated above, no portion of this lot lies within an officially designated flood plain.

Iron pins at all corners. Water, power and sewer services provided.

<p>Kermil J. Gould SC R.L.S. 4035</p>	PROPERTY OF Charles B. Campbell 203 ALAMO ST.	Date: 4 Sept 84
	Lot No. 40, Old G. J. Douglass Subdivision Greenville County, South Carolina 29505 CITY OF GREENVILLE	Scale: 1" = 30'
	K. T. GOULD, INC. 3228-A Wade Hampton Blvd. Taylors, SC.	Dwg. No.
		Own. By: K.G. 15-84
		Survey References: Block Sheet 145 Plat Bk "F" 126 Deed Vol.