



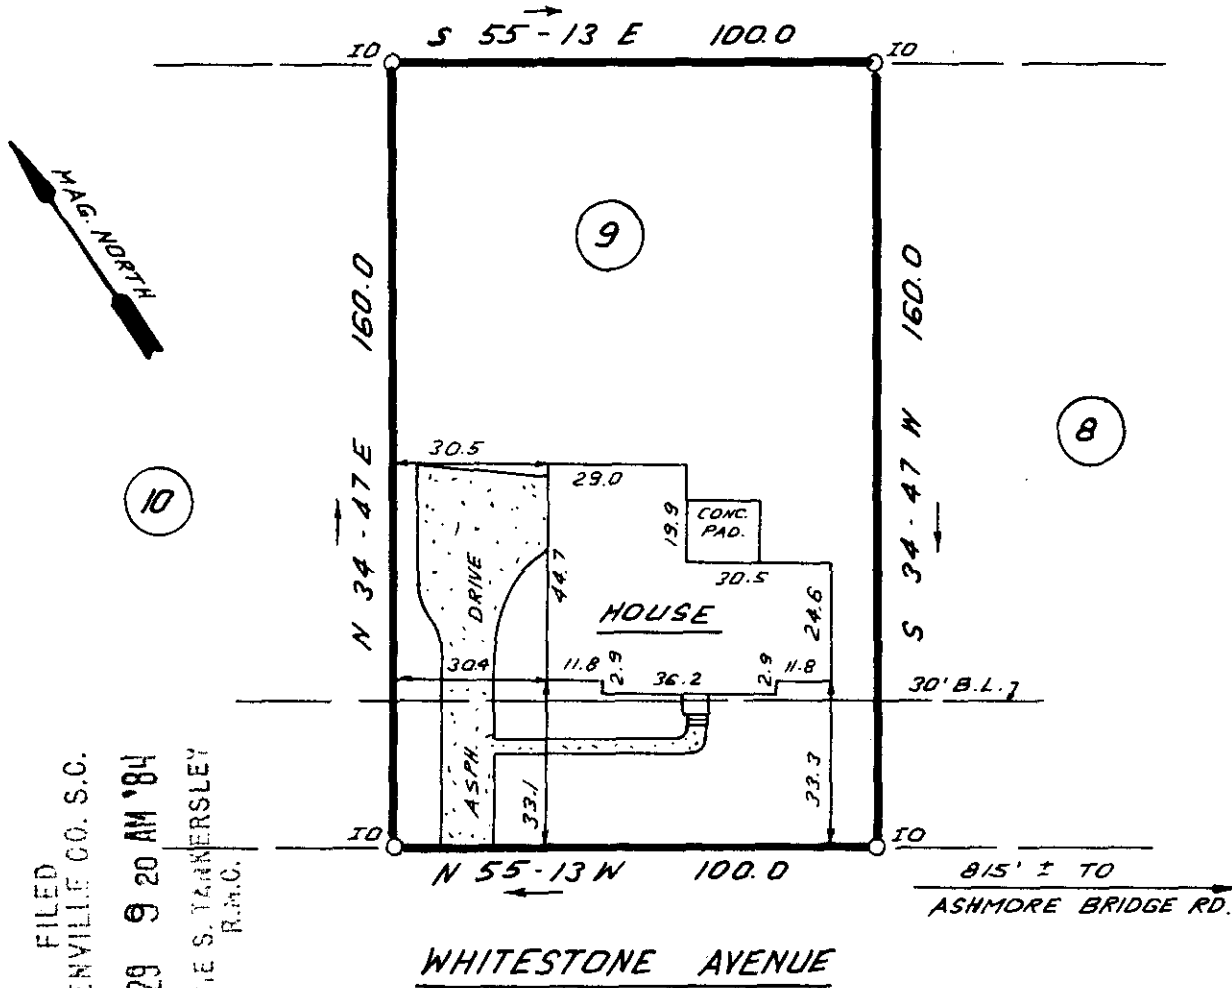

FILED
 GREENVILLE CO. S.C.
 OCT 29 9 20 AM '84
 JONNIE S. TARKERSLEY
 R.M.C.

WHITESTONE AVENUE

815' ± TO
 ASHMORE BRIDGE RD.

11-A-53

OCT 29 1984

12783



NOTE: 5' DRAINAGE EASEMENT ALONG ALL SIDE & REAR LOT LINES.

THIS IS TO CERTIFY THAT THE PROPERTY SHOWN ON THIS PLAT WAS SURVEYED UNDER MY DIRECT SUPERVISION. PROPERTY LINES AND IMPROVEMENTS SHOWN ARE LOCATED CORRECTLY AND THAT NO VISIBLE ENCROACHMENTS EXIST UNLESS OTHERWISE SHOWN THIS PROPERTY IS NOT LOCATED IN A DESIGNATED FLOOD HAZARD AREA



**STATE OF SOUTH CAROLINA
 GREENVILLE COUNTY**

ADAMS MILL ESTATES

LOT 9

PROPERTY OF

JOHNNY M. MICKLER, SR. ✓

TAMARA THOMPSON ↓

FREELAND & ASSOCIATES
 Engineers • Land Surveyors
 318 WEST STONE AVENUE.
 GREENVILLE, S.C.
 (803) 271-4924

PLAT BOOK	AR-31
DEED BOOK	1153-446
TAX MAP	M 7.5-1-9
PARTY CHIEF	J.E.C.
DRAWN	I.R.
DATE	10-25-84
DWG NO	11956