MICROFILMED

FILED
GREENVILLE CO. S.C.
OCT 31 10 47 AM '84
BONNIE S. DUCKERSLEY
R.M.C.

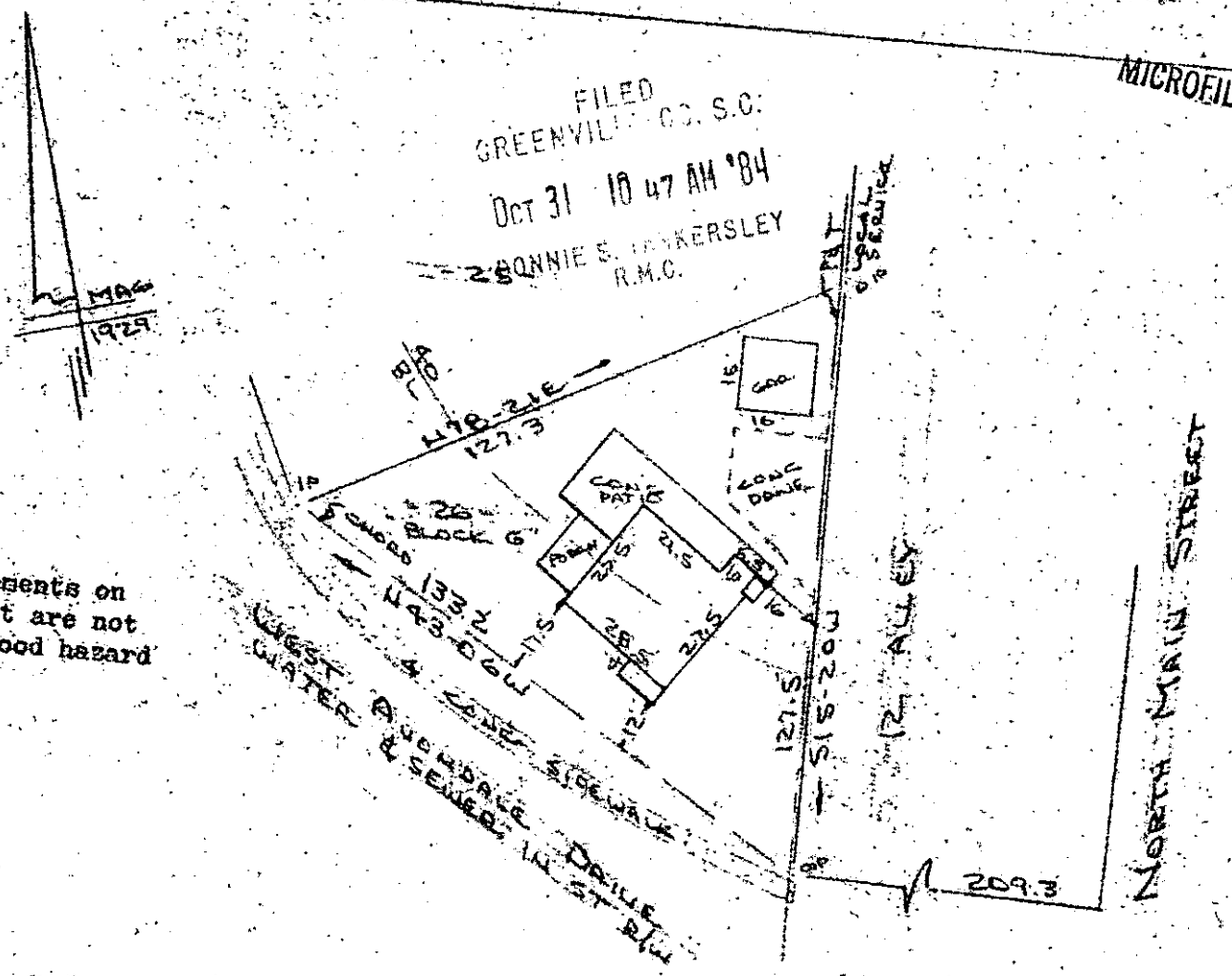

Note:
Improvements on this lot are not in a flood hazard area.

PROPERTY OF
DOUGLAS E. PHILLIPS & MARTHA P. MURDOCH
GREENVILLE COUNTY, GREENVILLE, S.C.
SCALE: 1"=40' 30 OCT 1984

This is to certify that on the 30th day of October, 1984, I surveyed the property shown on this plat, being known as lot 26 Block " G " on plat of NORTHGATE HEIGHTS and recorded in the RMC Office Greenville County, S. C., in Plat Book " G " at Pages 135 & 136; and that the property lines, walls and buildings are as shown hereon, and that the property lines, walls and buildings located on said lot do not encroach or project on adjacent street or property, and that no adjacent walls or buildings encroach or project on said premises, and no power lines cross this property except as shown hereon. Also being known as PROPERTY OF DOUGLAS E. PHILLIPS & MARTHA P. MURDOCH and recorded in the RMC Office Greenville County, S. C., in Plat Book at Page

OCT 31 1984

11A-67 13105

R. B. Bruce

R. B. Bruce, RLS# 1952

CAROLINA SURVEYING CO.
112 Manly St.
Greenville, S. C.

Recordable Plat

-2 OCT 31 '84 009

3.00CI