

FILED
GREENVILLE CO. S.C.
NOV 1 11 29 AM '84
DONNIE S. PARKERSLEY
R.M.C.


ASPHALT

WOODWARD STREET

196' ± TO
DORSEY BLVD.


NOV 1 1984

13368

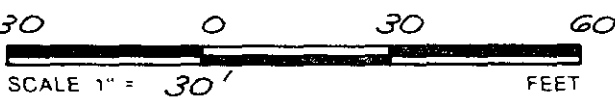

11-A-80

THIS IS TO CERTIFY THAT THE PROPERTY SHOWN ON THIS PLAT WAS SURVEYED UNDER MY DIRECT SUPERVISION PROPERTY LINES AND IMPROVEMENTS SHOWN ARE LOCATED CORRECTLY AND THAT NO VISIBLE ENCROACHMENTS EXIST UNLESS OTHERWISE SHOWN. THIS PROPERTY IS NOT LOCATED IN A DESIGNATED FLOOD HAZARD AREA

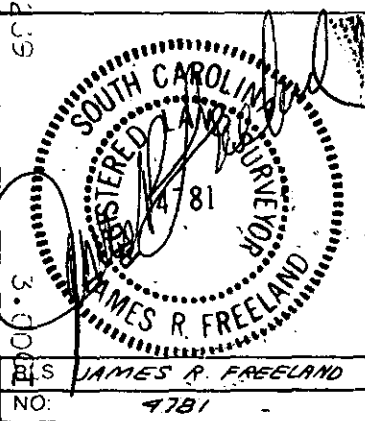

STATE OF SOUTH CAROLINA
GREENVILLE COUNTY

ABNEY MILLS
SEC 2 ; LOT 355
PROPERTY OF
SAMUEL E. BELCHER

FREELAND & ASSOCIATES
Engineers • Land Surveyors
318 WEST STONE AVENUE.
GREENVILLE, S.C.
(803) 271-4924

PLAT BOOK	99 @ 56
DEED BOOK	873 @ 347
TAX MAP	11B-2-1G
PARTY CHIEF	J.C.
DRAWN	K.E.G.
DATE	10-30-84
DWG NO	11986