


FILED
GREENVILLE CO. S.C.

NOV 2 2 40 PM '84

DONNIE S. PARKERSLEY
R.M.C.

MAG
1910

MICROFILMED

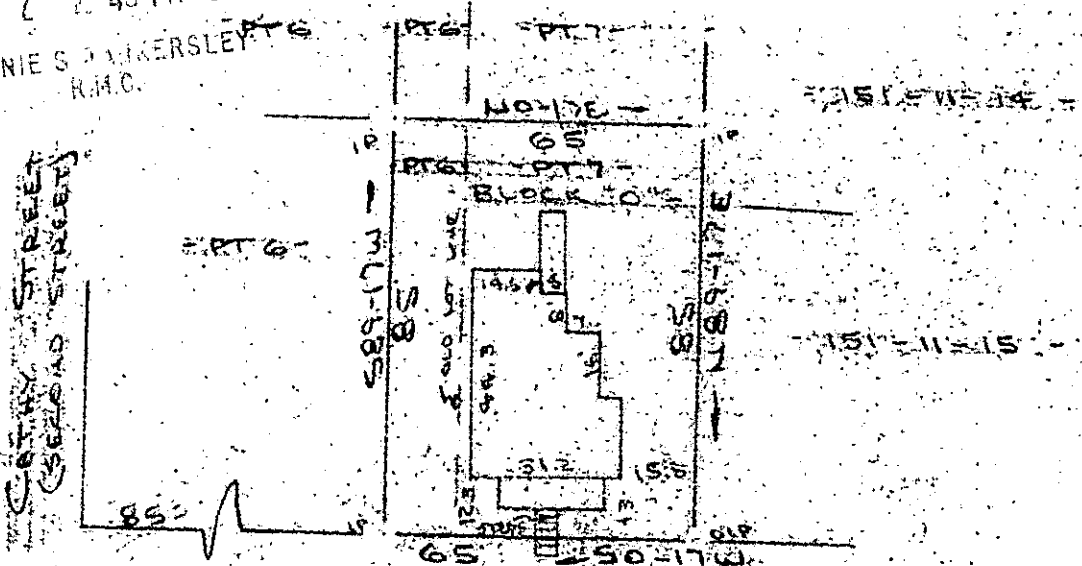


Note:

Improvements on this lot
are not in a flood hazard
area.

CAYERS STREET
PARK PLACE
WATER & SEWER

PROPERTY OF
DAVID A. SIZEMORE
NEAR GREENVILLE GREENVILLE COUNTY S.C.
SCALE 1" = 40' 26 OCT 1984

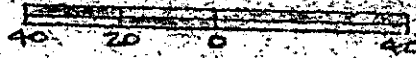

This is to certify that on the 26th day of October, 1984, I surveyed the property shown on this plat, being known as part of lot 6 & part of lot 7 Block "O" on plat of PARK PLACE and recorded in the RMC Office Greenville County, S. C., in Plat Book "A" at Page 119 and also being known as PROPERTY OF DAVID A. SIZEMORE and recorded in the RMC Office Greenville County, S. C., in Plat Book at Page ; and that the property lines, walls and buildings are as shown hereon, and that the walls and buildings located on said lot do not encroach or project on adjacent street or property, and that no adjacent walls or buildings encroach or project on said premises, and no power lines cross this property except as shown hereon.

11A-93
NOV 2 1984

13536 ✓

R. B. Bruce
R. B. Bruce, ELS # 1952

Recordable Plat

CAROLINA SURVEYING CO.
112 Mainly St.
Greenville, S. C.
GCTC -- 3 NO. 2 84 595

3.0001

262/25

PT 2