MICROFILMED

FILED
GREENVILLE CO. S.C.
NOV 8 10 38 AM '84
DONNIE S. TALKERSLEY
R.M.C.

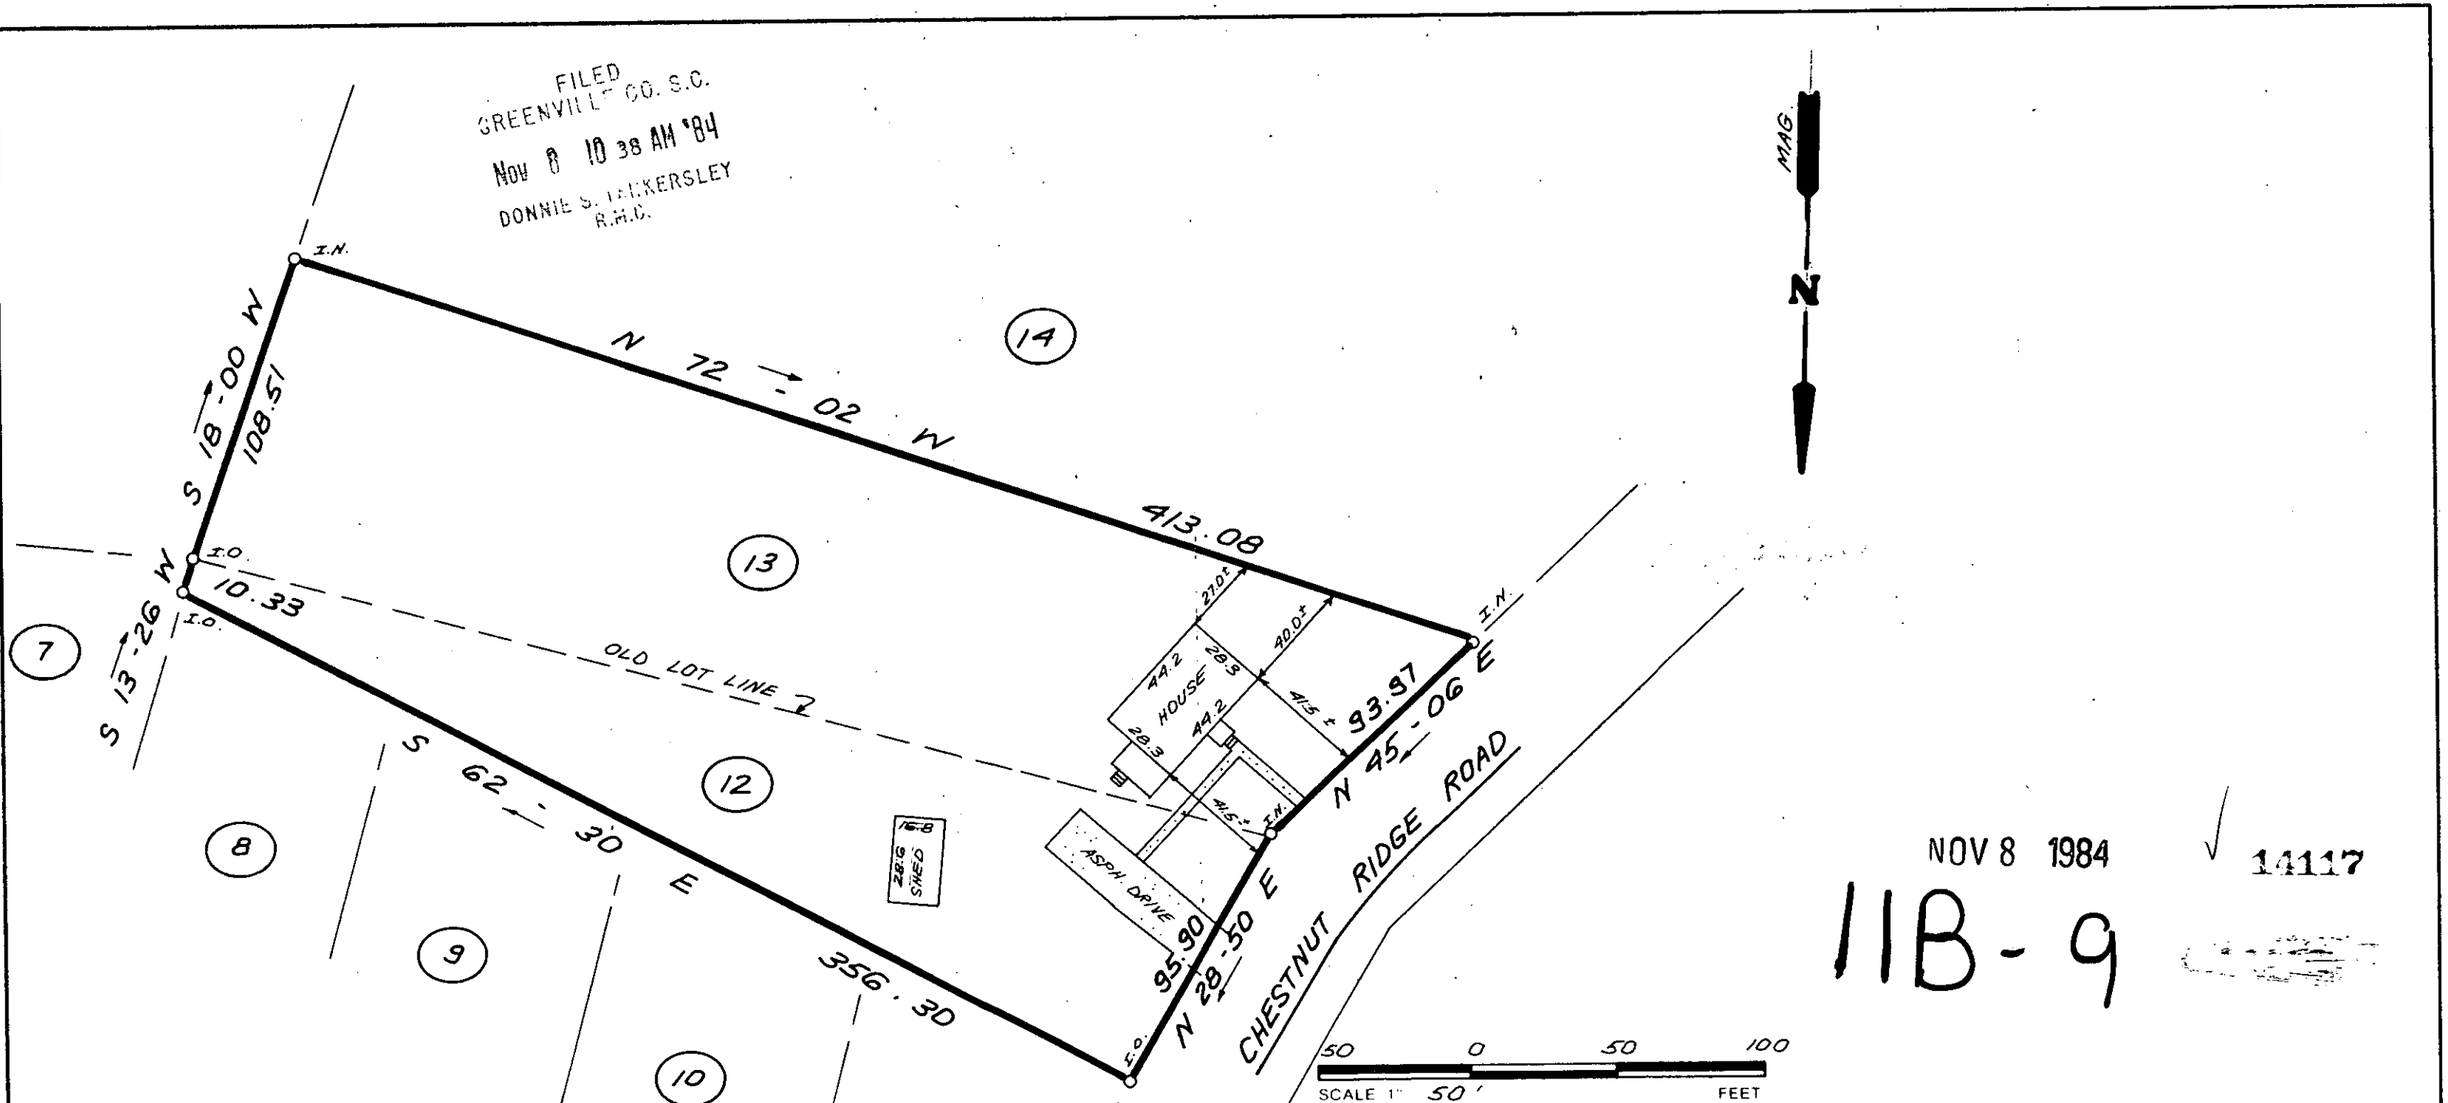

NOV 8 1984

14117

11B-9

THIS IS TO CERTIFY THAT THE PROPERTY SHOWN ON THIS PLAT WAS SURVEYED UNDER MY DIRECT SUPERVISION. PROPERTY LINES AND IMPROVEMENTS SHOWN ARE LOCATED CORRECTLY AND THAT NO VISIBLE ENCROACHMENTS EXIST UNLESS OTHERWISE SHOWN. THIS PROPERTY IS NOT LOCATED IN A DESIGNATED FLOOD HAZARD AREA.

SOUTH CAROLINA REGISTERED LAND SURVEYOR JAMES R. FREELAND 4781

RLS: JAMES R. FREELAND
NO: 4781

STATE OF SOUTH CAROLINA
GREENVILLE COUNTY

E.S. BULMAN PROPERTY
LOT 12 & 13
PROPERTY OF
KENNETH A. GARRETT
& DIANE M. GARRETT

FREELAND & ASSOCIATES
Engineers • Land Surveyors
318 WEST STONE AVENUE.
GREENVILLE, S.C.
(803) 271-4924

PLAT BOOK	BB @ 35A
DEED BOOK	1125-482
TAX MAP	519.6-1-47
PARTY CHIEF	R.A.J.
DRAWN	R.E.G.
DATE	NOV. 5, 1984
DWG. NO.	12,009

THE PRINT MACHINE, INC. N41289 A01 500 3