


Note: Information on this lot can be found in a "Sect. Plan" which
can be obtained from the City of Greenville,
Planning & Zoning Dept., 4th flr. 111 N. Main St.

FILED
GREENVILLE CO. S.C.

DEC 28 2 56 PM '84

DONNIE S. TANKERSLEY
R.M.C.

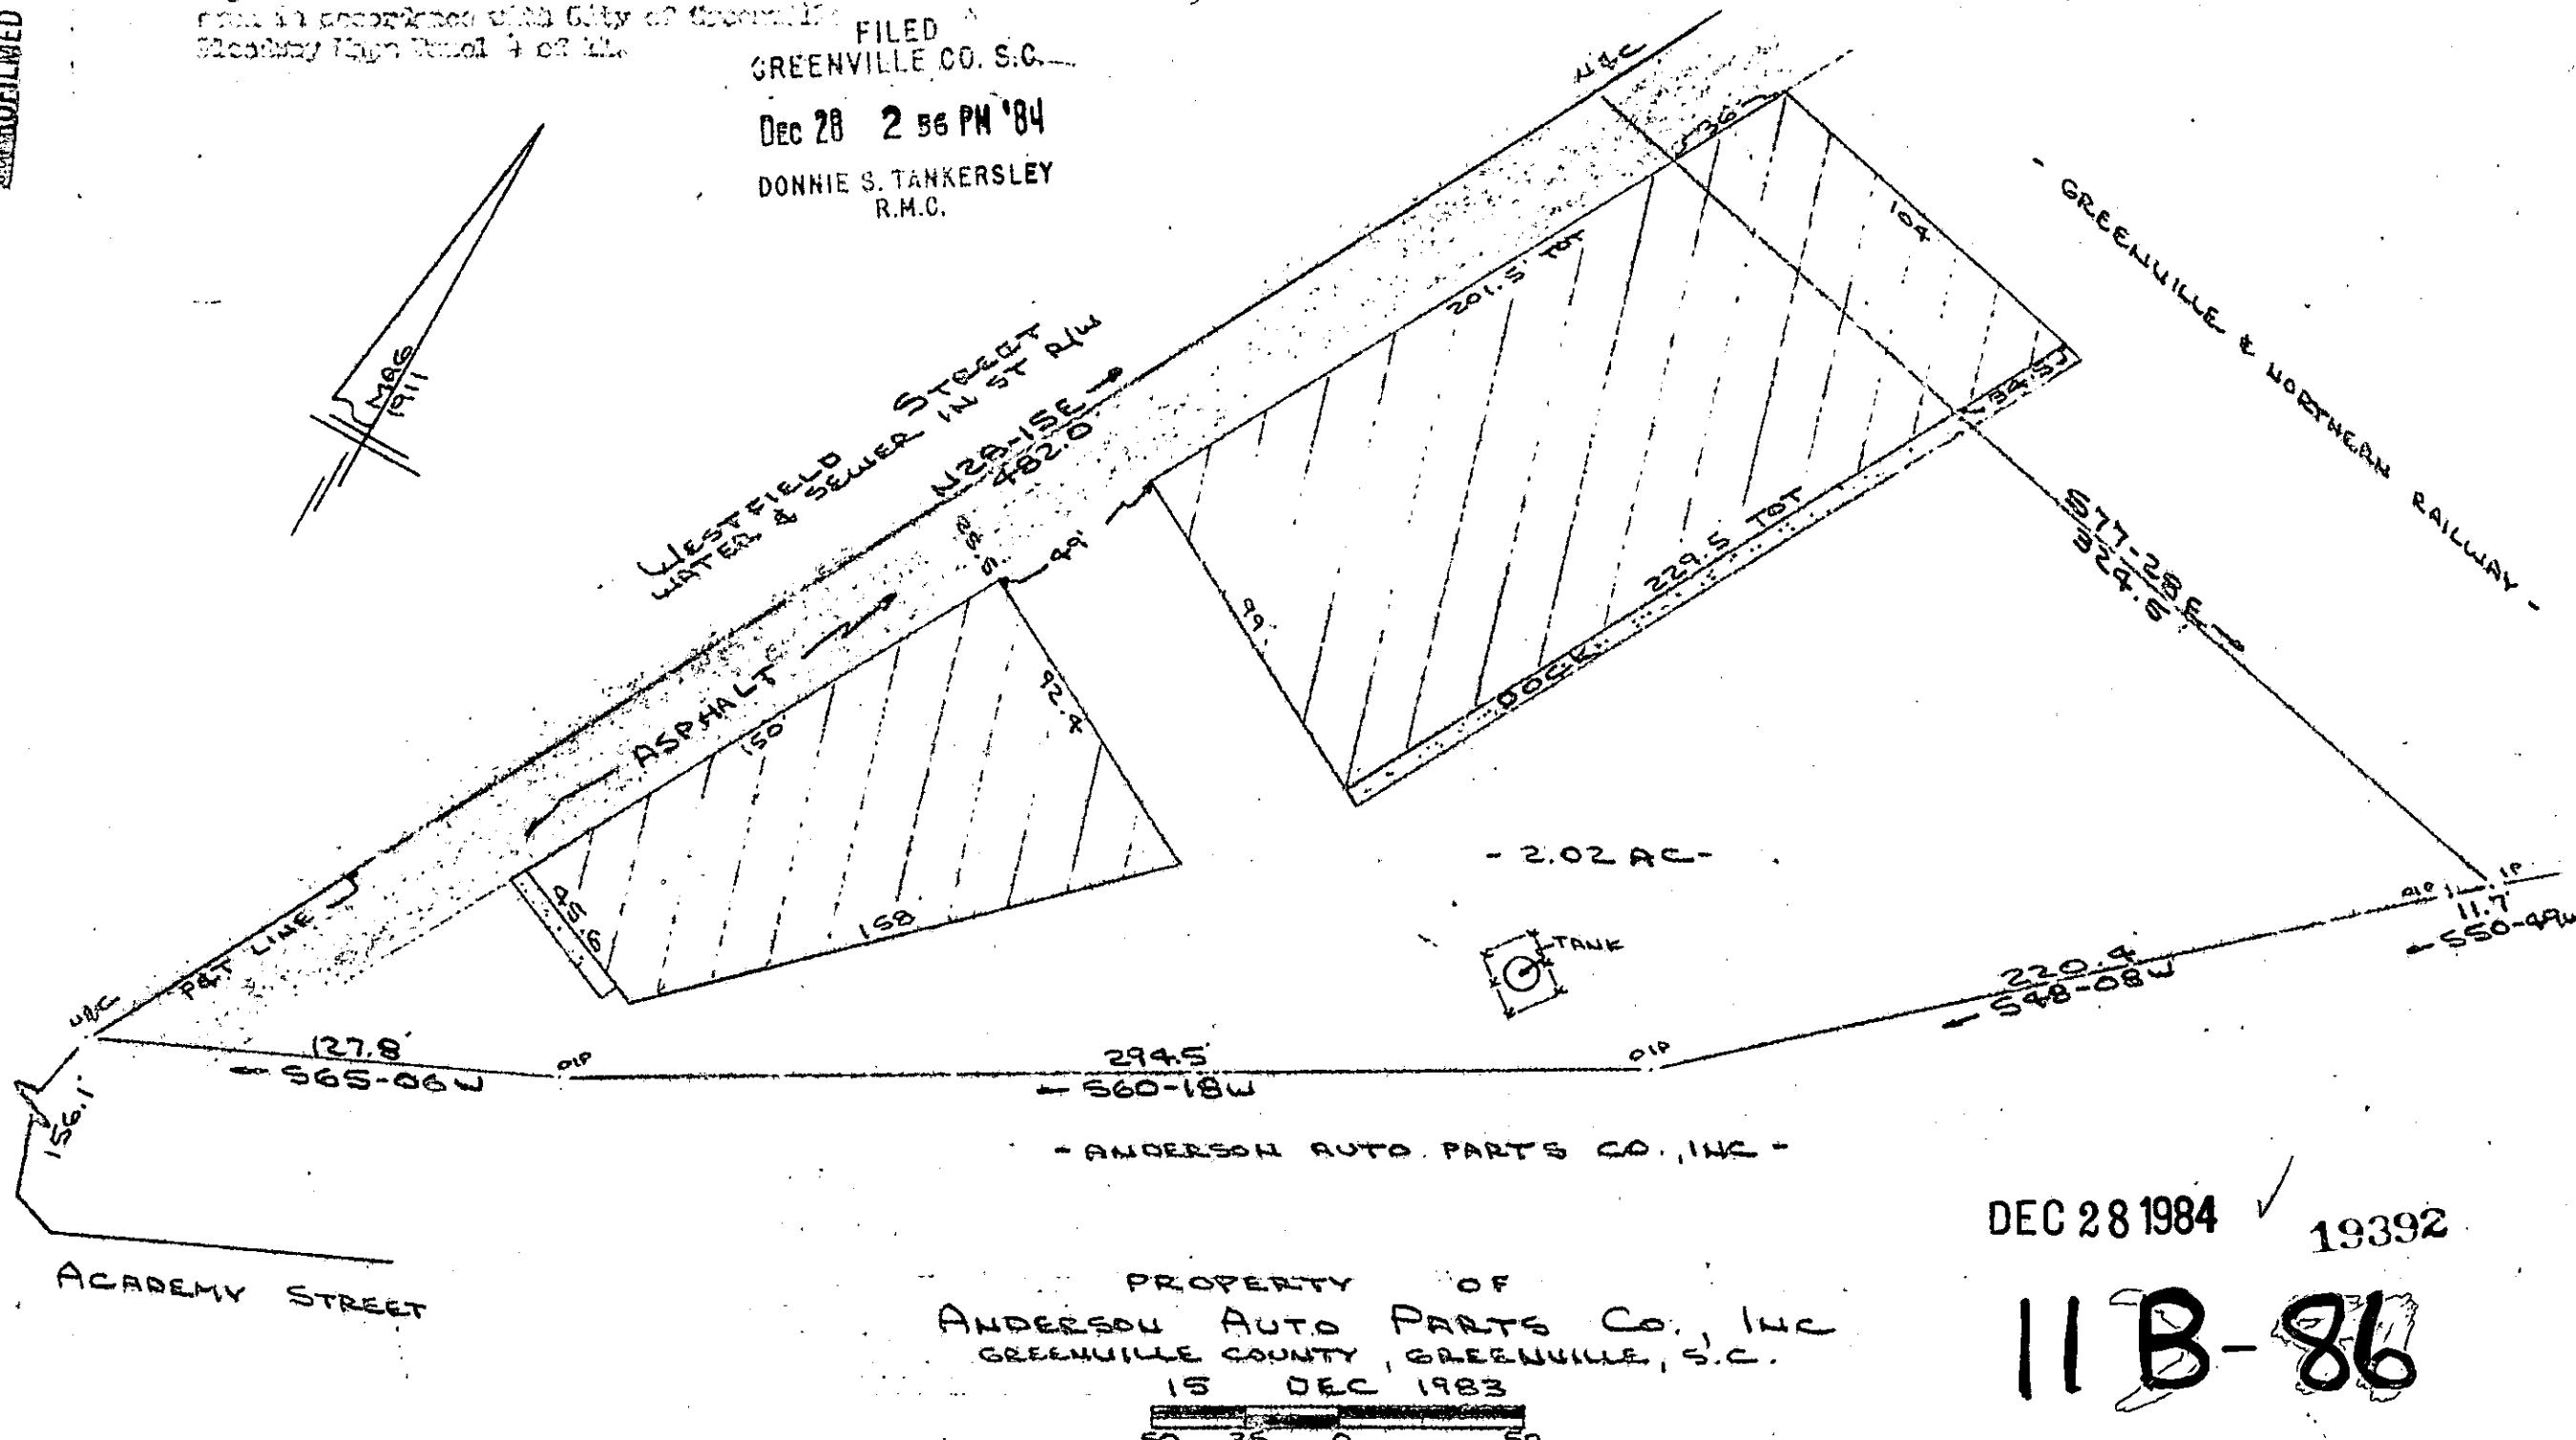

This is to certify that on the 13th day of December, 1983, I surveyed the property shown on this plan, being in area of 2.02 acres as plat 19392 in GREENVILLE CITY & COUNTY, and recorded in the Plat Book of Greenville County, S. C., in Plat Book "P" at Page 60 & 61 and also known as PROPERTY OF ANDERSON AUTO PARTS CO., INC. recorded in Plat Book "P" at Page 60 & 61, and that the property lines, walls and buildings are as shown heron, and that the walls and buildings located on said lots do not encroach or project on adjacent street or property, and that no adjacent walls or buildings encroach or project on said premises, and no power lines cross this property except on above mentioned property.

5.00C

R. B. Burchell, 1473
R. B. Burchell, 1473
RECORDED DECEMBER 28, 1983

Recordable Plat

CAROLINA SURVEYING CO., 112 Main St., Greenville, S.C.