

11-C-22


HOLLAND ROAD

NOV 15 1984



NOTE: 5' DRAINAGE & UTILITY EASEMENT ALONG EACH SIDE OF ALL SIDE & REAR LOT LINES.

THIS IS TO CERTIFY THAT THE PROPERTY SHOWN ON THIS PLAT WAS SURVEYED UNDER MY DIRECT SUPERVISION. PROPERTY LINES AND IMPROVEMENTS SHOWN ARE LOCATED CORRECTLY AND THAT NO VISIBLE ENCROACHMENTS EXIST UNLESS OTHERWISE SHOWN. THIS PROPERTY IS NOT LOCATED IN A DESIGNATED FLOOD HAZARD AREA.

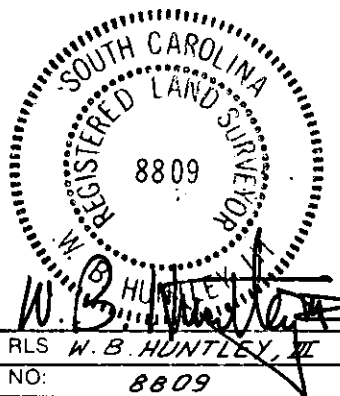

STATE OF SOUTH CAROLINA GREENVILLE COUNTY

GILDER CREEK ESTATES
 PHASE I; LOT 21
 PROPERTY OF
 JOHN V. TOMAN
 LAURIE L. TOMAN

FREELAND & ASSOCIATES
 Engineers • Land Surveyors
 318 WEST STONE AVENUE.
 GREENVILLE, S.C.
 (803) 271-4924

PLAT BOOK	9W - 68
DEED BOOK	
TAX MAP	
PARTY CHIEF	J.E.C.
DRAWN	I.R.
DATE	10-22-84
DWG. NO.	11932