


Note:  
Improvements on this  
lot are not in a  
flood hazard area.

FILED  
GREENVILLE CO. S.C.  
NOV 21 3 29 PM '84  
DONNIE S. TANKERSLEY  
R.M.O.

NEW STREET  
WATER & SEWER IN ST R/W.  
PROPERTY OF  
DIANNE FAIR  
NEAR GREENVILLE, GREENVILLE CO., S.C.  
SCALE: 1"=40'  
OCT 19, 1984

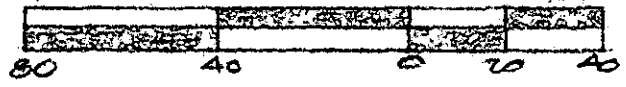

This is to certify that on the 19th day of October, 1984, I surveyed the property shown on this plat, being known as lot 1 on plat of PROPERTY OF JUANITA W. PATRICK and recorded in the RMC Office Greenville County, S. C., in Plat Book "HH" at Page 1 and also known as PROPERTY OF DIANNE FAIR and recorded in Plat Book at Page ; and that the property lines, walls and buildings are as shown hereon, and that the walls and buildings located on said lot do not encroach or project on adjacent street or property, and that no adjacent walls or buildings encroach or project on said premises, and no power lines cross this property except as shown hereon.

✓ 11-C-62

15663

R. B. Bruce  
R. B. Bruce, RLS # 1952  
Recordable Plat  
(19262)

CAROLINA SURVEYING CO.  
112 Manly St., Greenville, S.C.