MICROFILMED

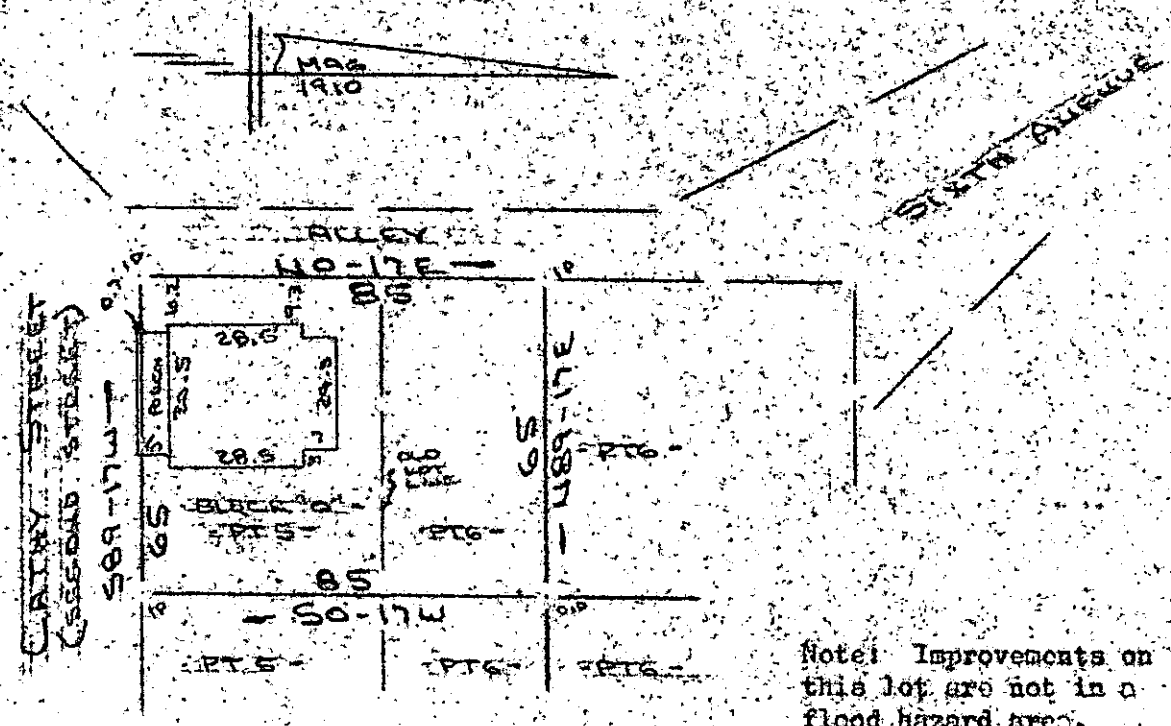

Note: Improvements on this lot are not in a flood hazard area.

PROPERTY OF
DAVID A. SIZEMORE
NEAR GREENVILLE, GREENVILLE COUNTY, S.C.
SCALE: 1"=40' 21 NOV 1984

40 20 0 40

This is to certify that on the 21st day of November, 1984, I surveyed the property shown on this plat, being known as part of lot 5 and part of lot 6 Block " O " on plat of PARK PLACE and recorded in the RMC Office Greenville County, S. C., in Plat Book " A " at Page 119; and also known as PROPERTY OF DAVID A. SIZEMORE and recorded in Plat Book at Page ; and that the property lines, walls and buildings are as shown hereon, and that the walls and buildings located on said lot do not encroach or project on adjacent street or property, and that no adjacent walls or buildings encroach or project on said premises, and no power lines cross this property except as shown hereon.

R. B. Bruce

R. D. Bruce, RLS # 1952

FILED
GREENVILLE CO. S.C.
Nov 29 11 23 AM '84
DONNIE S. TANKERSLEY
R.M.C.

CAROLINA SURVEYING CO.
112 Manly St.
Greenville, S. C.

Recordable Plat

16262

11-C-86

300 s 1180