

FILED
GREENVILLE CO. S.C.
NOV 30 9 59 PM '84
DONNIE S. TANKERSLEY
R.M.C.

NOTE:
5' UTILITY & DRAINAGE EASEMENT
ALONG ALL SIDE AND REAR LOT
LINES.

BRENTWOOD AVE

16513



11-C-96

NOV 30 1984


THIS IS TO CERTIFY THAT THE PROPERTY SHOWN ON THIS PLAT WAS SURVEYED UNDER MY DIRECT SUPERVISION PROPERTY LINES AND IMPROVEMENTS SHOWN ARE LOCATED CORRECTLY AND THAT NO VISIBLE ENCROACHMENTS EXIST UNLESS OTHERWISE SHOWN THIS PROPERTY IS NOT LOCATED IN A DESIGNATED FLOOD HAZARD AREA

STATE OF SOUTH CAROLINA
GREENVILLE COUNTY

FREELAND & ASSOCIATES
Engineers • Land Surveyors
318 WEST STONE AVENUE.
GREENVILLE, S.C.
(803) 271-4924

¹
CROFTSTONE ACRES
SEC. F; LOT 9
PROPERTY OF
BARRY L. BRIGHAM

PLAT BOOK	Y @ 91
DEED BOOK	1173 @ 265
TAX MAP	183.1 - 3 - 6
PARTY CHIEF	B.G.
DRAWN	K.E.G.
DATE	NOV. 28, 1984
DWG NO	12, 127

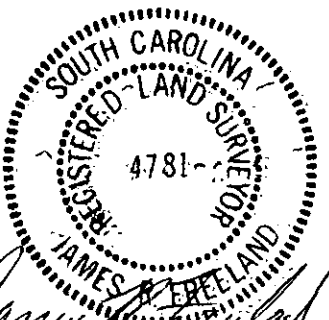

RLS JAMES R. FREELAND
NO 4781

SC10-1 NO30 84 072

3.0000