MICROFILMED

FILED
GREENVILLE CO. S.C.
DEC 4 10 20 AM '84
DONNIE S. TANKERSLEY
R.M.C.

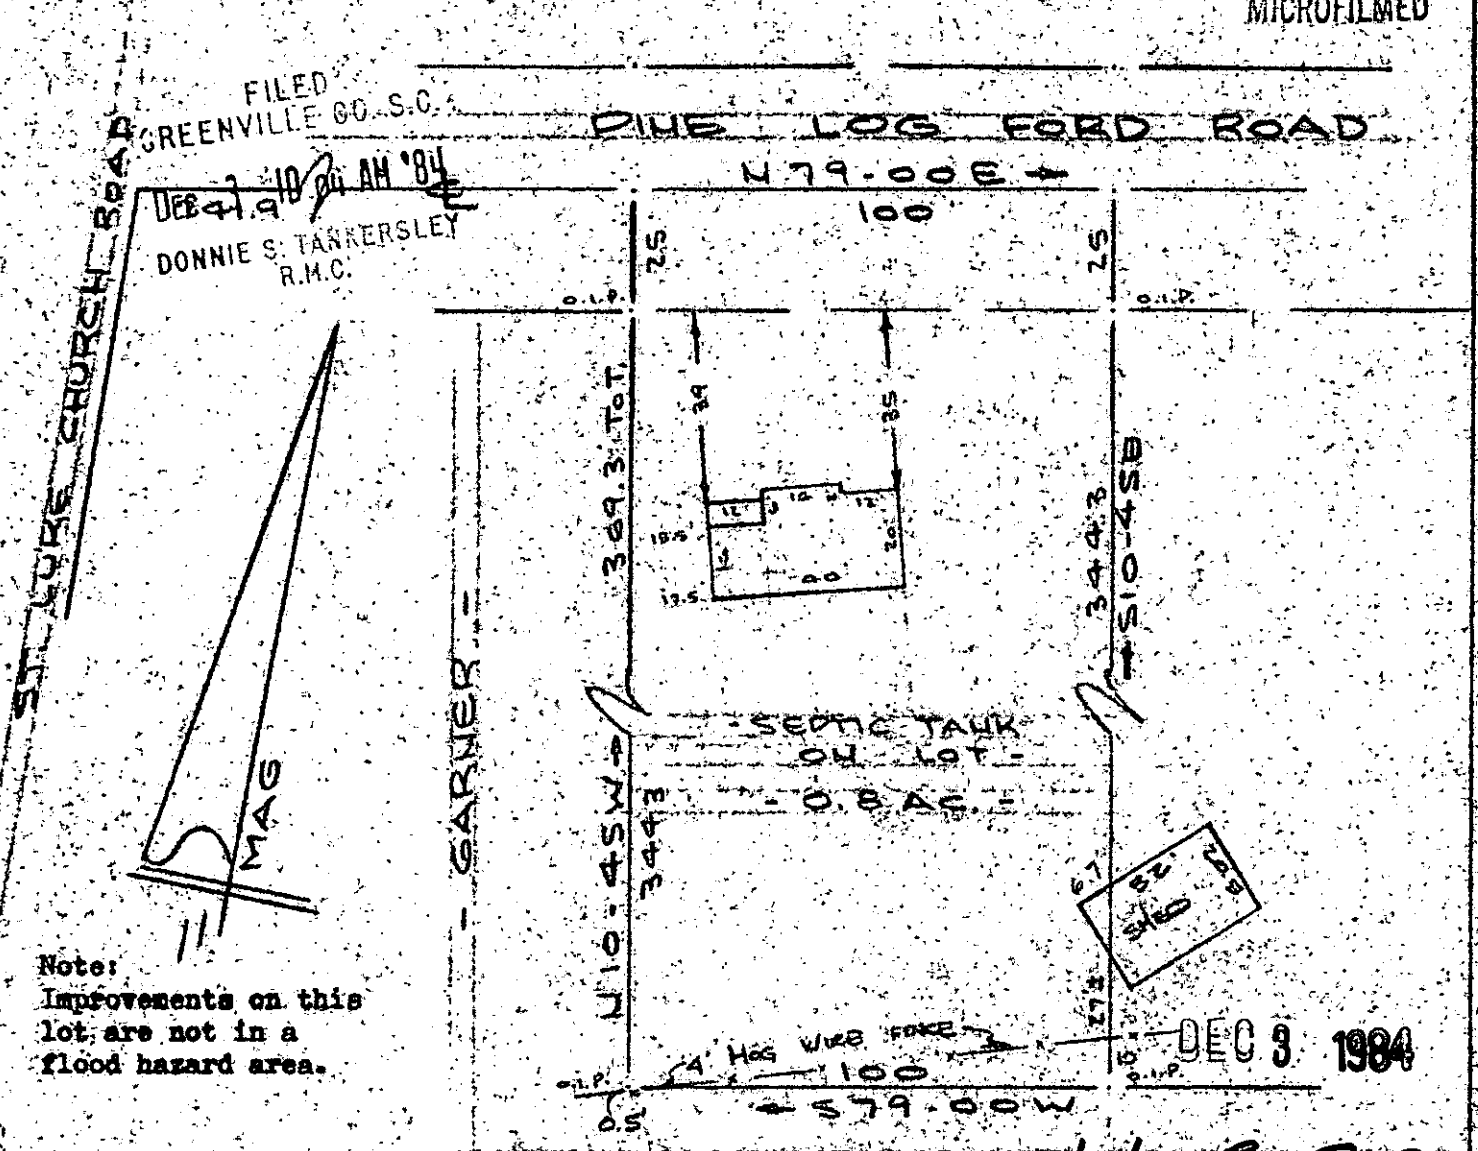

Note:
Improvements on this lot are not in a flood hazard area.

DEC 3 1984

11-C-99

16644

PROPERTY OF
WILLIAM KEITH KERNS & LUE YATA KERNS
NEAR GREENVILLE, S. C.
SCALE: 1" = 40'
27 NOV 1984

This is to certify that on the 27th day of November, 1984, I surveyed the property shown on this plat, being known as 0.8 acres on plat of PROPERTY OF JAMES H. HARRELSON & SARA E. HARRELSON and recorded in the RMC Office Greenville County, S. C., in Plat Book " 8-G " at Page 30 ; and that the property lines, walls and buildings are as shown hereon, and that the walls and buildings located on said lot do not encroach or project on adjacent street or property, and that no adjacent walls or buildings encroach or project on said premises, and no power lines cross this property except as shown hereon.

R. B. Bruce

R. B. Bruce, RLS #1952

CAROLINA SURVEYING CO.
112 Manly St.
Greenville, S. C.

Recordable Plat

ECTO ---- DEC 3 84 031

3.00CD