


Note: Barricades on  
this lot do not COUNTRY CLUB DRIVE  
in a fence. SPARK DRAINED  
WATER & SEWER IN ST AND  
HOARD ACR.

**MICROFILMED**

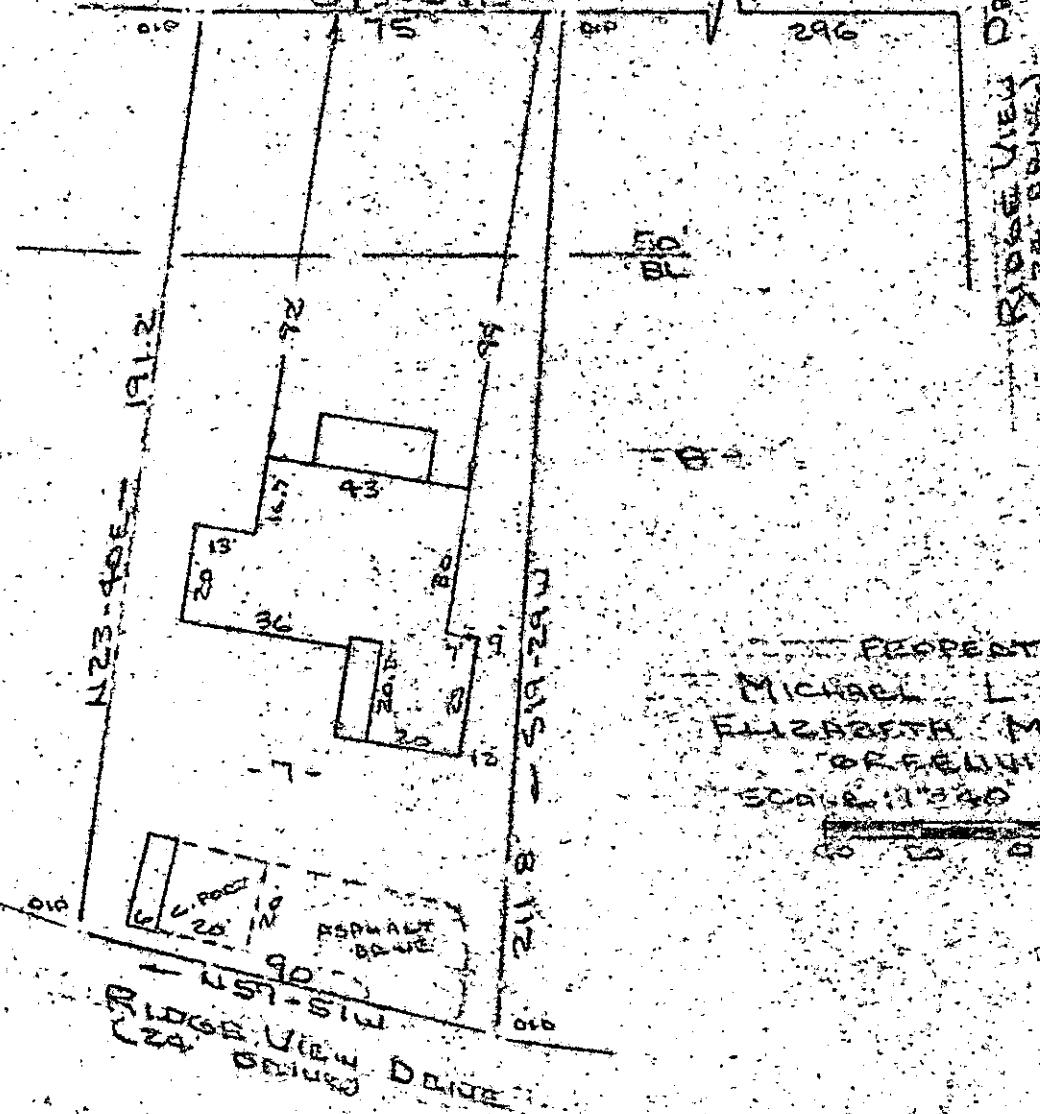

This is to certify that on the 30th day of November, 1924, I surveyed the property shown on this plat, being known as lot 7 on Plat of PROPERTY OF ROGER C. PEACE et al and recorded in the REC Office Greenville County, S. C., in Plat Book "K" at Page 60; and that the property, lines, walls and buildings located on said lot do not encroach or project on adjacent street or property, and that no adjacent walls or buildings encroach or project on said premises, and no power lines cross this property except as shown heron.

16689

R. B. Bruce, P.S. 1953

11-D-5

FILED  
GREENVILLE CO. S.C.  
12 42 PM '84  
DEC 3 1984  
TANKERSLEY  
DONNIE S. B.M.C.

CAROLINA SURVEYING CO.  
112 Manly St.  
Greenville, S. C.

# Recordable Plat