


MICROFILMED

FILED  
GREENVILLE CO. S.C.  
DEC 9 2 20 PM '84  
DONNIE S. TANKERSLEY  
R.M.C.

LOT 50

LOT 49

LOT 48

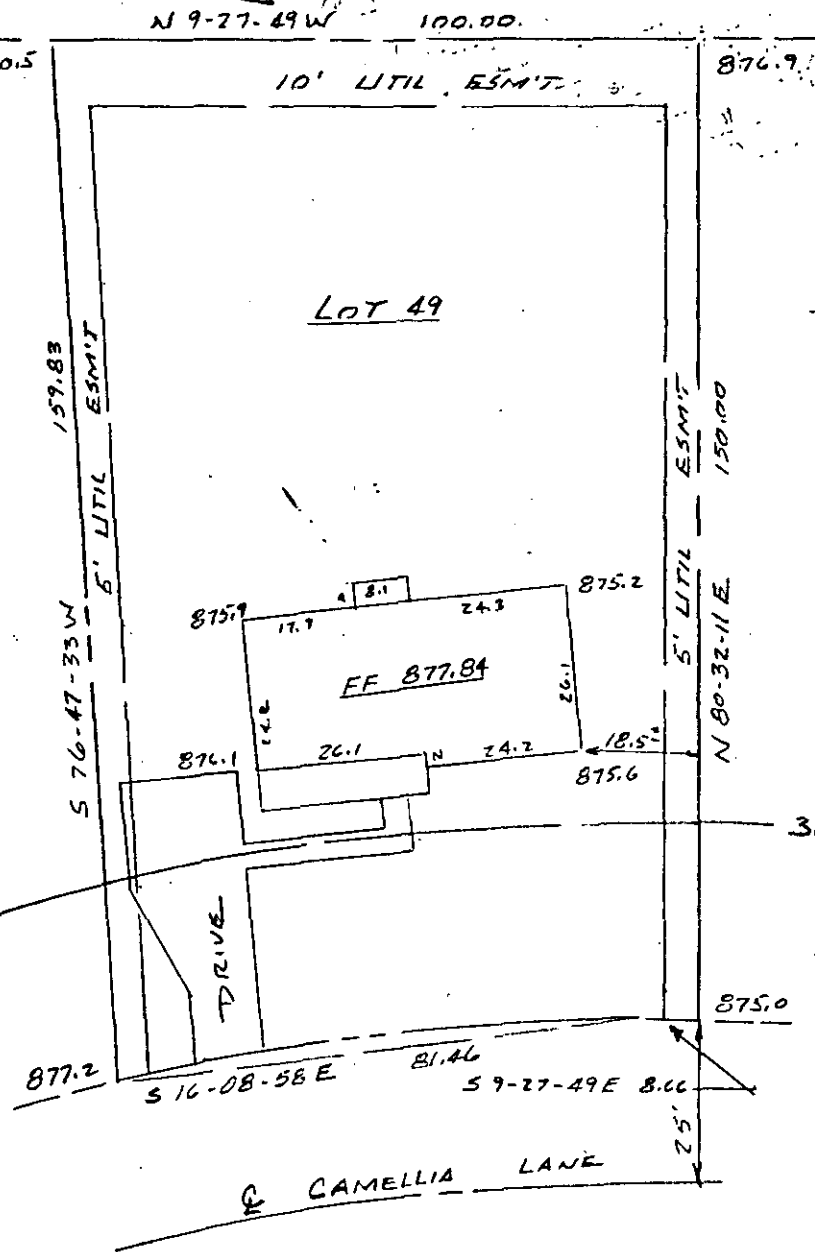

Greenville County  
South Carolina

DEC 7 1984

Date: October 3, 1984  
Scale: 1" = 30'

Plat and building location of Lot 49, Wedgefield Subdivision, Section II, belonging to Joanne J. Bennett, and recorded in Plat Book 9-W, page 11, Office of R.M.C. I hereby certify that the measurements as shown on this plat are correct and there are no encroachments or projections other than shown; and to the best of my knowledge, after checking the Flood Hazard Boundary Map, this lot does not lie in a designated flood zone.

11-D-25

17273

*Ronald E. Starkman*  
Registered Land Surveyor #5291  
GREENVILLE COUNTY S.C.  
REGISTERED SURVEYOR  
RONALD E. STARKMAN

Heaner engineering co., Inc.  
greenwood, s. c.