


Note:
Improvements on this lot
are not in a flood hazard
area.

PROPERTY OF
WILLIAM MC SWAIN BURDETT JR & JO SHERRI SHALL
CITY OF GREENVILLE, S.C.
SCALE 1" = 40'
6 DEC 1984

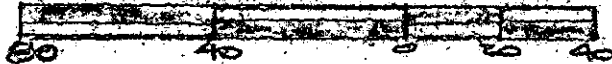

This is to certify that on the 6th day of December, 1984, I surveyed the property shown on this plat, being known as lot 92 on plat of MAP NO. 3 SAN SOUCI HEIGHTS, and recorded in the RMC Office Greenville County, S. C., in Plat Book " Z " at Page 95; and that the property lines, walls and buildings are as shown hereon, and that the walls and buildings located on said lot do not encroach or project on adjacent street or property, and that no adjacent walls or buildings encroach or project on said premises, and no power lines cross this property except as shown hereon.

17329

DEC 7 1984

11-D-27

R. B. Bruce

R. B. Bruce, RLS # 1952

Recordable Plat

DOONIE S. TANKERSLEY
R.M.C.

Dec 7 3 45 PM '84

FILED
GREENVILLE CO. S.C.

CAROLINA SURVEYING
112 Manly St.
Greenville, S. C.

CO.