



FILED  
 GREENVILLE CO. S.C.  
 NORTH  
 DEC 12 11 07 AM '84  
 DONALD S. TANKERSLEY M  
 R.M.C.

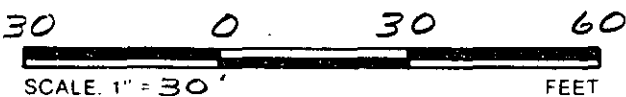

DEC 12 1984  
 11 D - 35  
 17729

THIS IS TO CERTIFY THAT THE PROPERTY SHOWN ON THIS PLAT WAS SURVEYED UNDER MY DIRECT SUPERVISION  
 PROPERTY LINES AND IMPROVEMENTS SHOWN ARE LOCATED CORRECTLY AND THAT NO VISIBLE ENCROACHMENTS  
 EXIST UNLESS OTHERWISE SHOWN THIS PROPERTY IS NOT LOCATED IN A DESIGNATED FLOOD HAZARD AREA

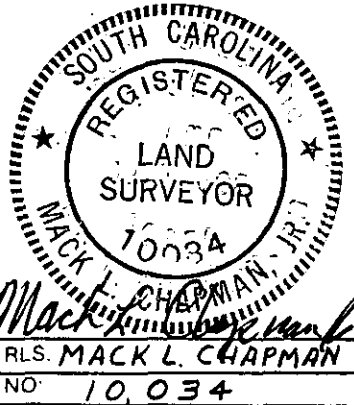

STATE OF SOUTH CAROLINA  
 GREENVILLE COUNTY  
 DEL NORTE ESTATES  
 LOT 35  
 PROPERTY OF  
 ALAN J. TURNER  
 EVELYN K. TURNER

FREELAND & ASSOCIATES  
 Engineers • Land Surveyors  
 318 WEST STONE AVENUE.  
 GREENVILLE, S.C.  
 (803) 271-4924  
 PLAT BOOK WW-32  
 DEED BOOK 1030-900  
 TAX MAP 538.9-1-19  
 PARTY CHIEF B.G.  
 DRAWN M.L.C.  
 DATE 12-8-84  
 DWG NO 84-12,180

2011294 1511  
 3.0001