MICROFILMED

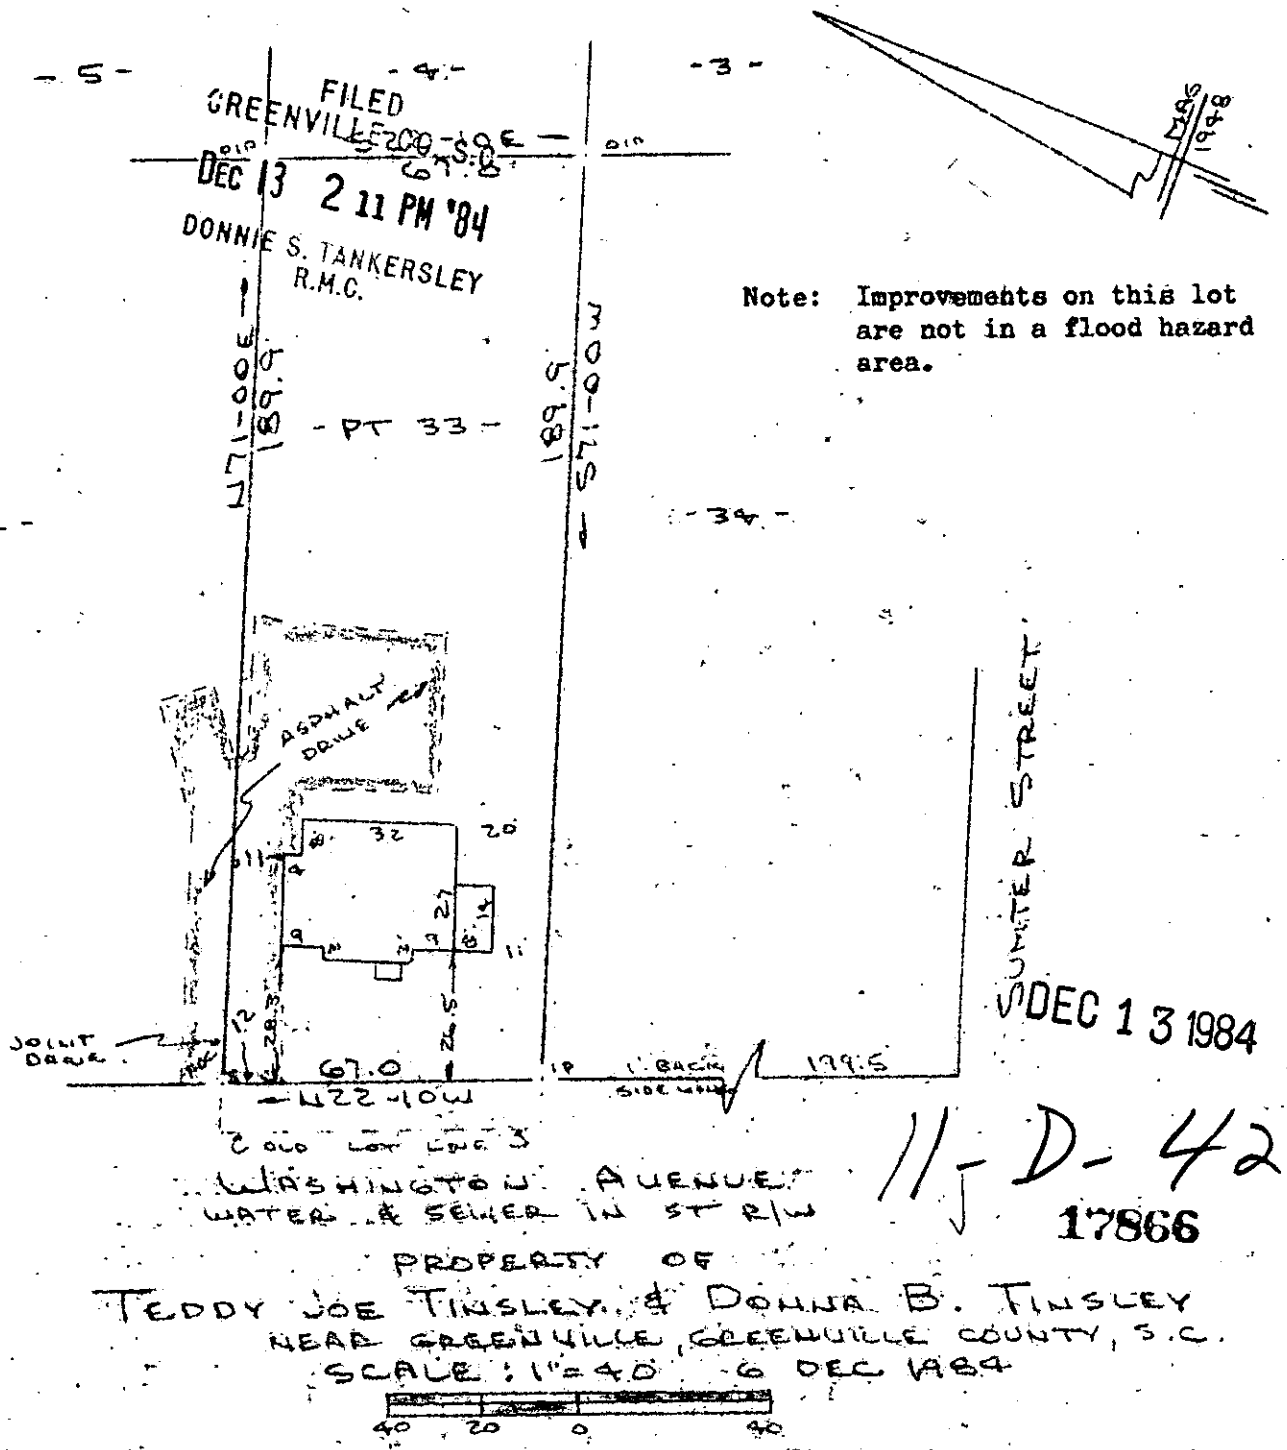

11-D-42

17866

This is to certify that on the 6th day of December, 1984, I surveyed the property shown on this plat, being known as part of lot 33 on plat of PROPERTY OF NONA HARRIS SQUIRES and recorded in the RMC Office Greenville County, S. C., in Plat Book " S " at Page 151; and that the property lines, walls and buildings are as shown hereon, and that the walls and buildings located on said lot do not encroach or project on adjacent street or property, and that no adjacent walls or buildings encroach or project on said premises, and no power lines cross this property except as shown hereon. Also known as PROPERTY OF TEDDY JOE TINSLEY & DONNA B. TINSLEY and recorded in Plat Book at Page .

R. B. Bruce

R. B. Bruce, RLS # 1952

CAROLINA SURVEYING CO.
112 Manly St.
Greenville, S. C.

Recordable Plat

GCTO ----- I DE13 84 042

3.00CD