


FILED
GREENVILLE CO. S.C.
DEC 24 10 52 AM '84
DONNIE S. TANKERSLEY
R.M.C.

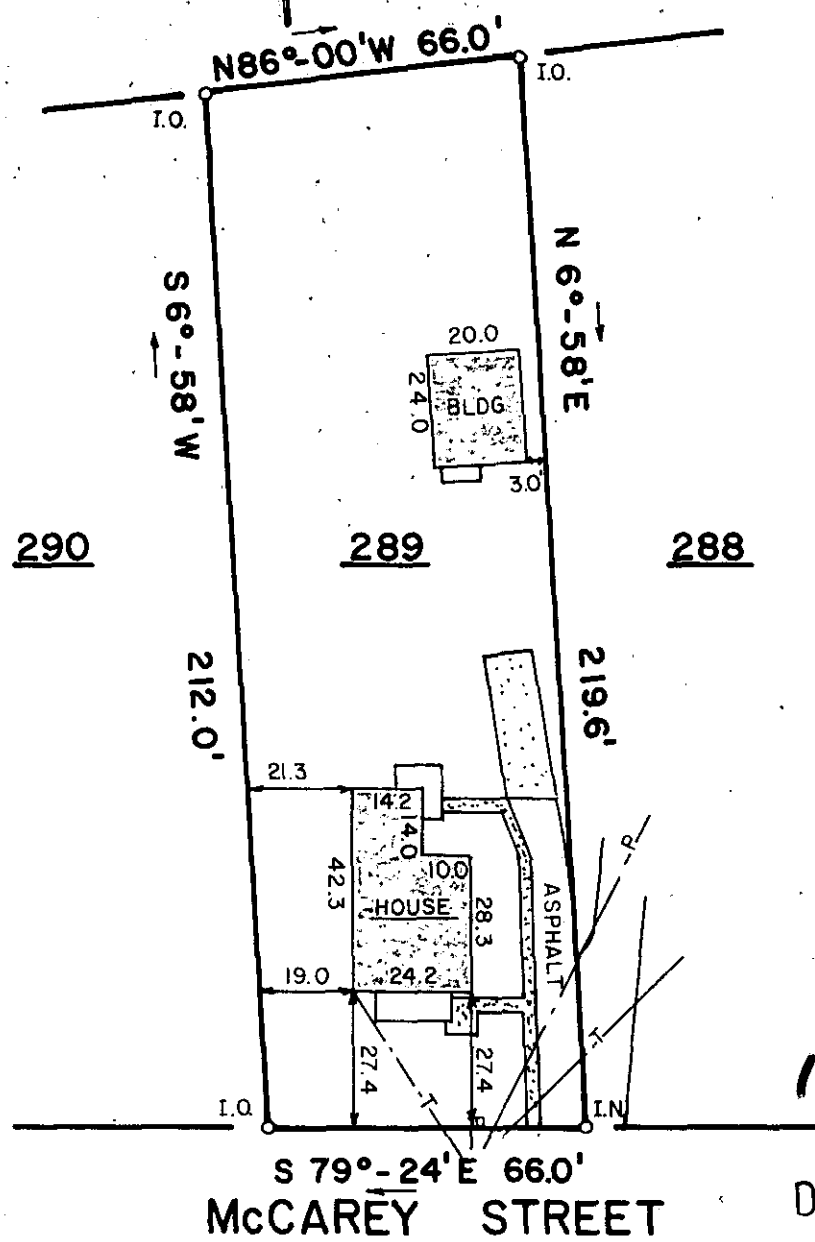

18934

11-D-74

DEC 24 1984


McCAREY STREET

This is to certify that on December 18, 1984, I surveyed the property shown on this plat, known as Lot 289 on plat of McCarey Tract, recorded in the R.M.C. Office of Greenville County, in Plat Book A on Page 278, and that the property lines, walls and buildings are as shown hereon, that the building located on said lot does not encroach or project on adjacent streets or property, and that no adjacent walls or buildings encroach or project on said premises, and that no utility lines R/W's cross this property except as shown hereon. This property is not located in a Designated Flood Hazard Area.

Frederick E. Landrith
Frederick E. Landrith PLS 9545

LANDRITH SURVEYING
LAND SURVEYORS

4416 WHITE HORSE ROAD
GREENVILLE, SOUTH CAROLINA
0 40 80

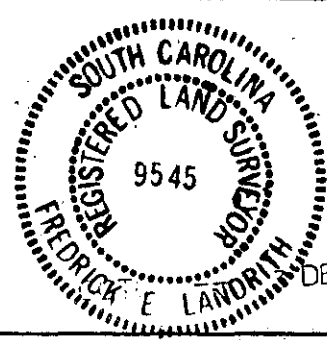

STATE of SOUTH CAROLINA
GREENVILLE COUNTY

McCAREY TRACT
LOT 289
PROPERTY OF

JAMES R. COLEY
SANDRA H. COLEY

SURVEYED BY FEL CK'D BY FEL

DRAWN BY FEL DATE 12/19/84

SEAL

PROJECT NO. 84-154