MICROFILMED

FILED
GREENVILLE CO. S.C.
JAN 3 10 19 AM '85
DONNIE S. TANKERSLEY
R.M.C.

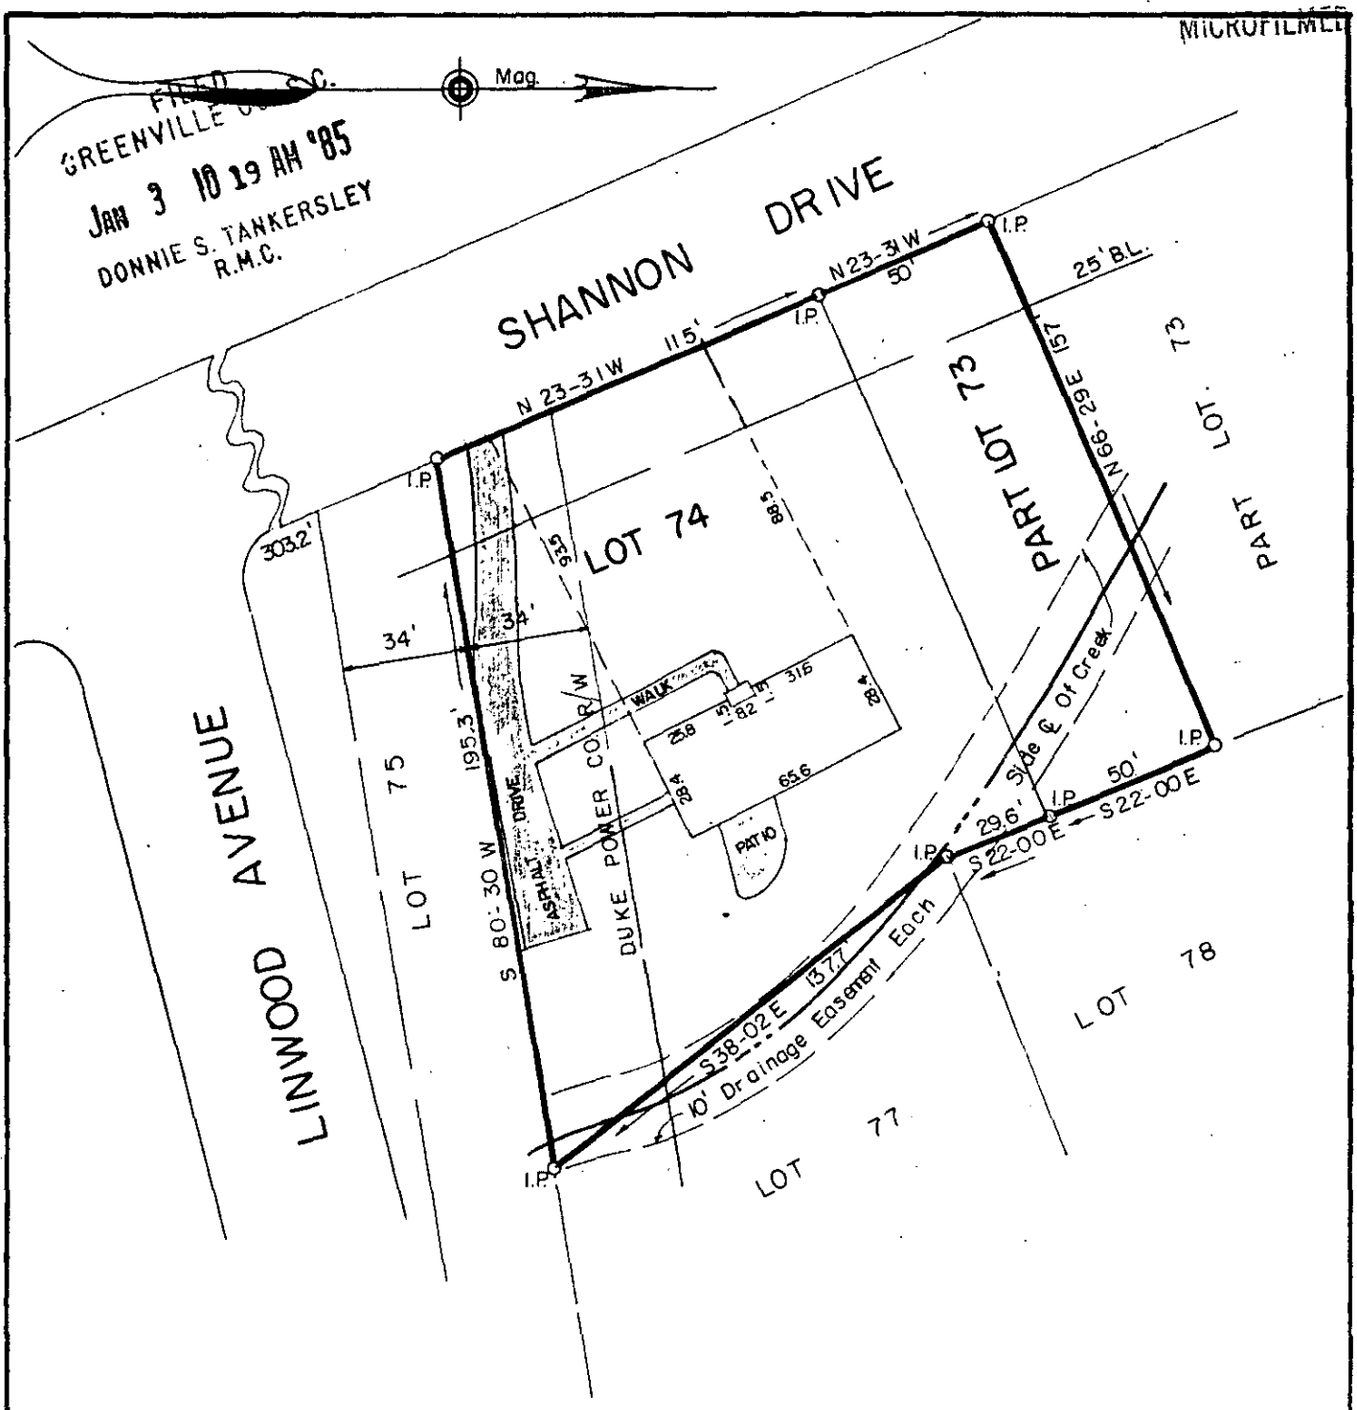

PROPERTY OF

DANIEL H. CASH, JR.

GREENVILLE CO., S.C.

Scale 1" = 50' December, 1984

This is to certify that on the 21st day of December, 1984, we surveyed the property shown on this plat being known as Part Lot 73 and Lot 74 on plat of McSwain Gardens, recorded in plat book GG, page 75, Office of R.M.C., Greenville County, S.C.; and that the property lines, walls and buildings are as shown hereon; that the buildings located on said lot do not encroach or project on adjacent streets or property; and that no adjacent buildings or walls encroach or project on said premises; and from information from Greenville County, this structure is not loatedd in a designated flood area.

19854 ✓

JAN 3 1985

11E-6

R.W. Dalton

DALTON & NEVES CO., INC. ENGINEERS

F.B. 493
S.C. Reg. No. 916

6CTO ----- 1 JA03 85 063
3.00CD