


MILLER ROAD

Note: 5' drainage & utility easement along each side of all side & rear lot lines.

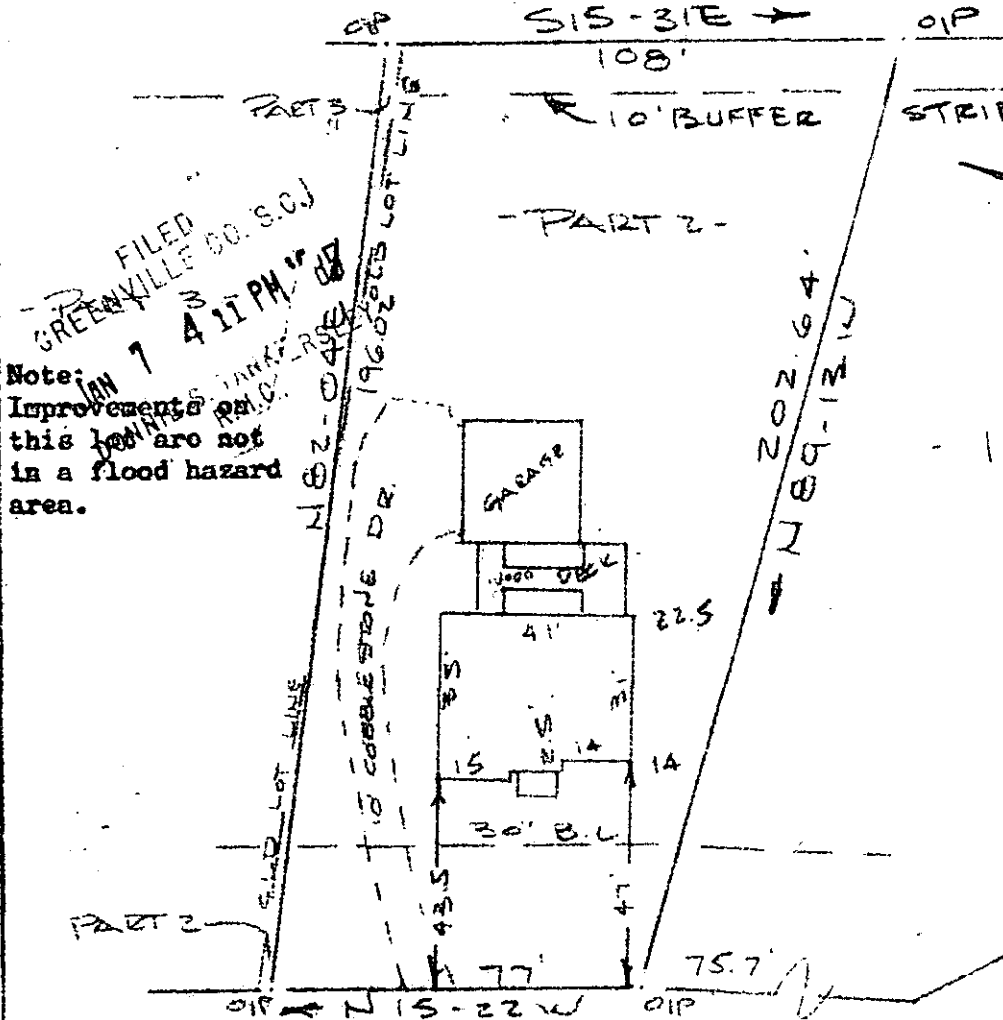

FILED GREENVILLE CO. S.C. JAN 7 4 11 PM '85

Note: Improvements on this lot are not in a flood hazard area.


JAN 7 1985

LOBLOLLY LANE WATER & SEWER IN ST RV

11-E-17 20209

PROPERTY OF RONALD G. JONES & MIRIAM Y. JONES MAULDIN, S.C.

SCALE 1" = 40'

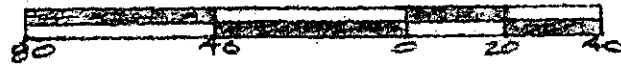

This is to certify that on the 31st day of December, 1984, I surveyed the property shown on this plat, being known as part of lot 2 and part of lot 3 on plat of FORRESTER WOODS SECTION 6 and recorded in the REC Office Greenville County, S. C., in Plat Book " 9 - W " at Page 7 and FORRESTER WOODS SEC. 6 PARTS LOTS 2 & 3 and recorded in Plat Book " 10 - Y " at Page 68; and that the property lines, walls and buildings are as shown hereon, and that the walls and buildings located on said lot do not encroach or project on adjacent street or property, and that no adjacent walls or buildings encroach or project on said premises, and no power lines cross this property except as shown hereon.

CAROLINA SURVEYING CO.
112 Hanly St.
Greenville, S.C.

R. B. Bruce, RLS # 1972
930

Recordable Plat
JAN 7 1985