

N 24 44 W 426.54

I.O. I.O.

FILED  
GREENVILLE CO. S.C.

JAN 10 1 53 PM '85

DONNIE S. TANKERSLEY  
R.M.C.




N/F  
JAMES H. MADDOX

S 68 06 W 499.15

4.37 AC.

L.P.

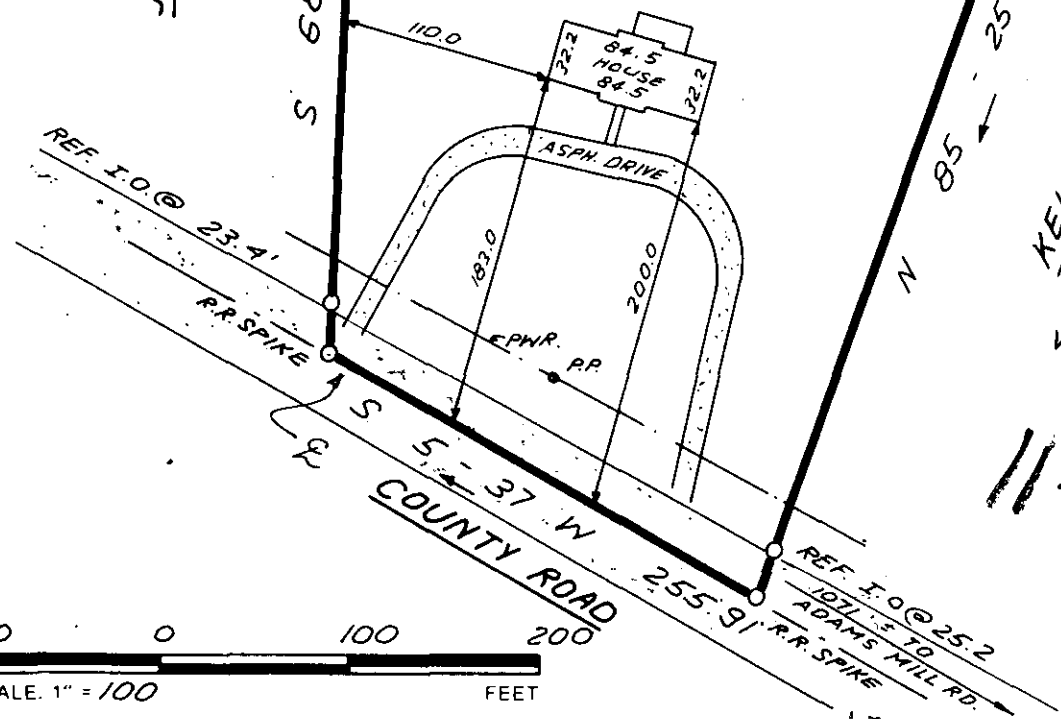


20562

11-E-26

JAN 10 1985

SCALE 1" = 100 FEET

THIS IS TO CERTIFY THAT THE PROPERTY SHOWN ON THIS PLAT WAS SURVEYED UNDER MY DIRECT SUPERVISION PROPERTY LINES AND IMPROVEMENTS SHOWN ARE LOCATED CORRECTLY AND THAT NO VISIBLE ENCROACHMENTS EXIST UNLESS OTHERWISE SHOWN. THIS PROPERTY IS NOT LOCATED IN A DESIGNATED FLOOD HAZARD AREA

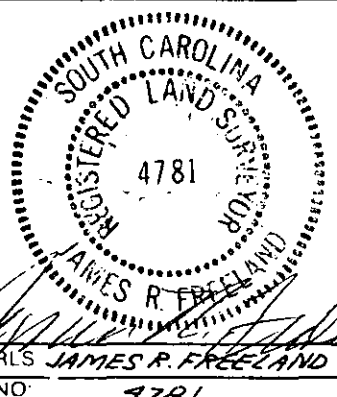

STATE OF SOUTH CAROLINA  
GREENVILLE COUNTY

FREELAND & ASSOCIATES  
Engineers • Land Surveyors  
318 WEST STONE AVENUE.  
GREENVILLE, S.C.  
(803) 271-4924

SURVEY FOR  
JAMES L. LEWIS  
BRENDA C. LEWIS

PLAT BOOK	6X-53
DEED BOOK	1092-529
TAX MAP	548.1-1-25.9
PARTY CHIEF	J.E.C.
DRAWN	K.E.G.
DATE	JAN 8, 1985
DWG NO	12312

GC10 -----1 JA10 85 009 3.00CD