


N. NORTH STREET EXT  
WATER & SEWER IN ST R/W

S.C. Hwy 291

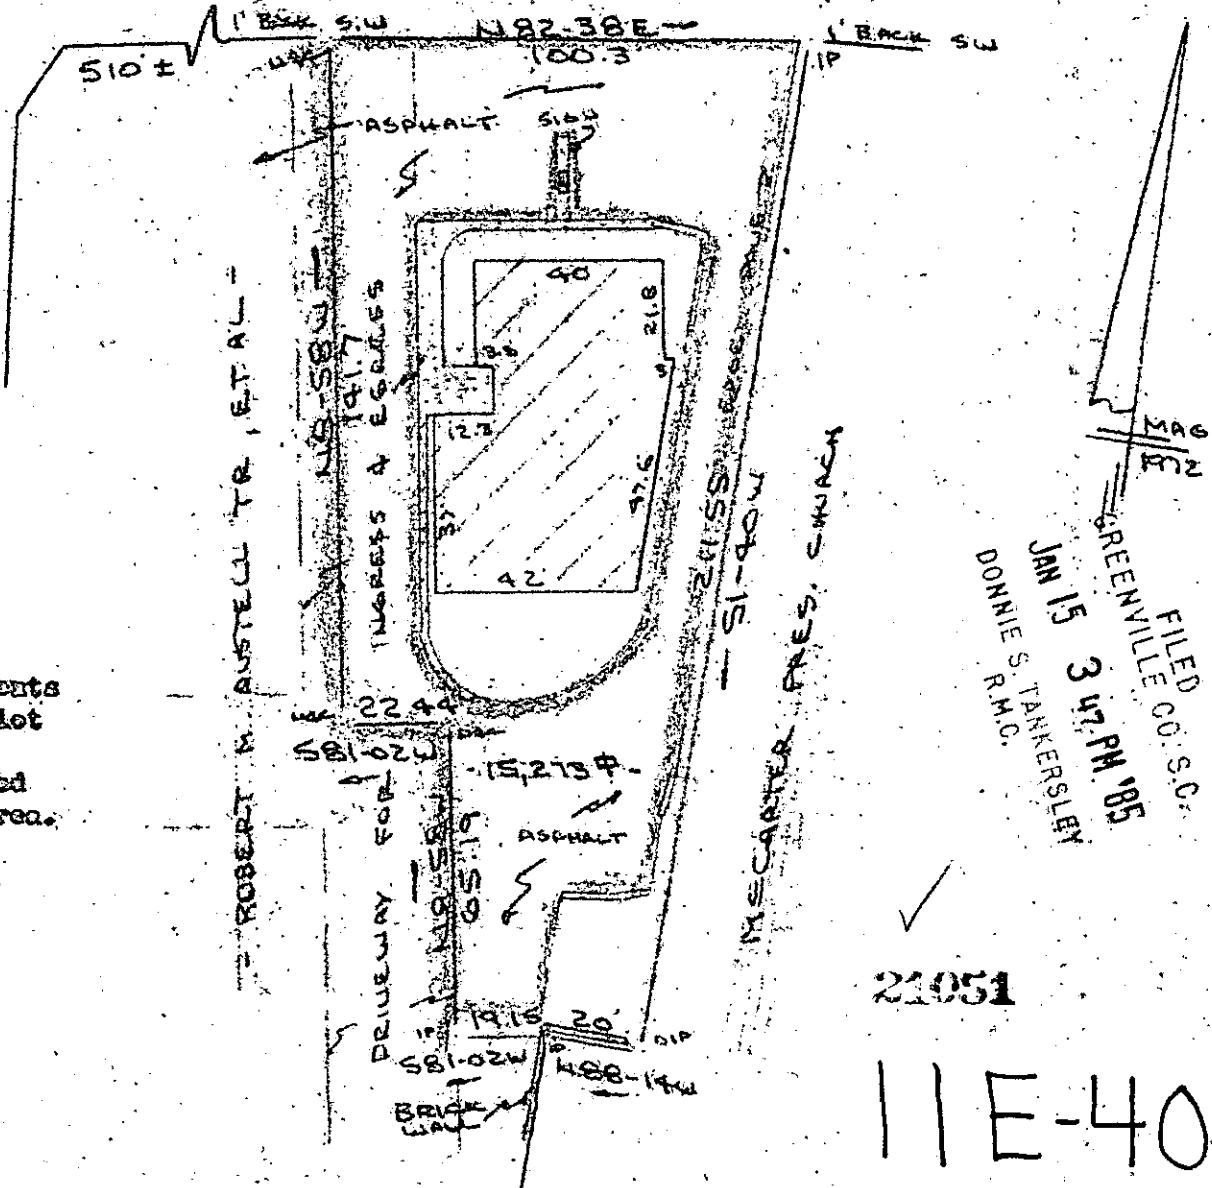


Note:  
Improvements  
on this lot  
are not  
in a flood  
hazard area.

FILED CO. S.C.  
GREENVILLE  
JAN 15 3 47 PM '85  
DONNIE S. TANKERSLEY  
R.M.C.

21051

11E-40

PROPERTY OF  
L. STEWART SPINKS  
GREENVILLE COUNTY, GREENVILLE, S.C.  
SCALE: 1"=40' 8 JAN 1985

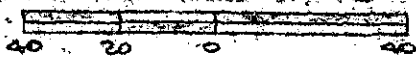

JAN 15 1985

This is to certify that on the 8th day of January, 1985, I surveyed the property shown on this plat, being known as lot on plat of JACK E. SHAW, WHITE STORES INC., CAROLINA FEDERAL SAVINGS & LOAN ASSOCIATION and recorded in the REC Office Greenville County, S. C., in Plat Book "4 - II" at Page 66 and also known as PROPERTY OF L. STEWART SPINKS and recorded in Plat Book at Page and that the property lines, walls and buildings are as shown hereon, and that the walls and buildings located on said lot do not encroach or project on adjacent street or property, and that no adjacent walls or buildings encroach or project on said premises, and no power lines cross this property except as shown hereon.

*R. B. Bruce*  
R. B. Bruce, RLS # 1852

GC70 -----1 JA1585 015 3.00CD