


MICROFILMED

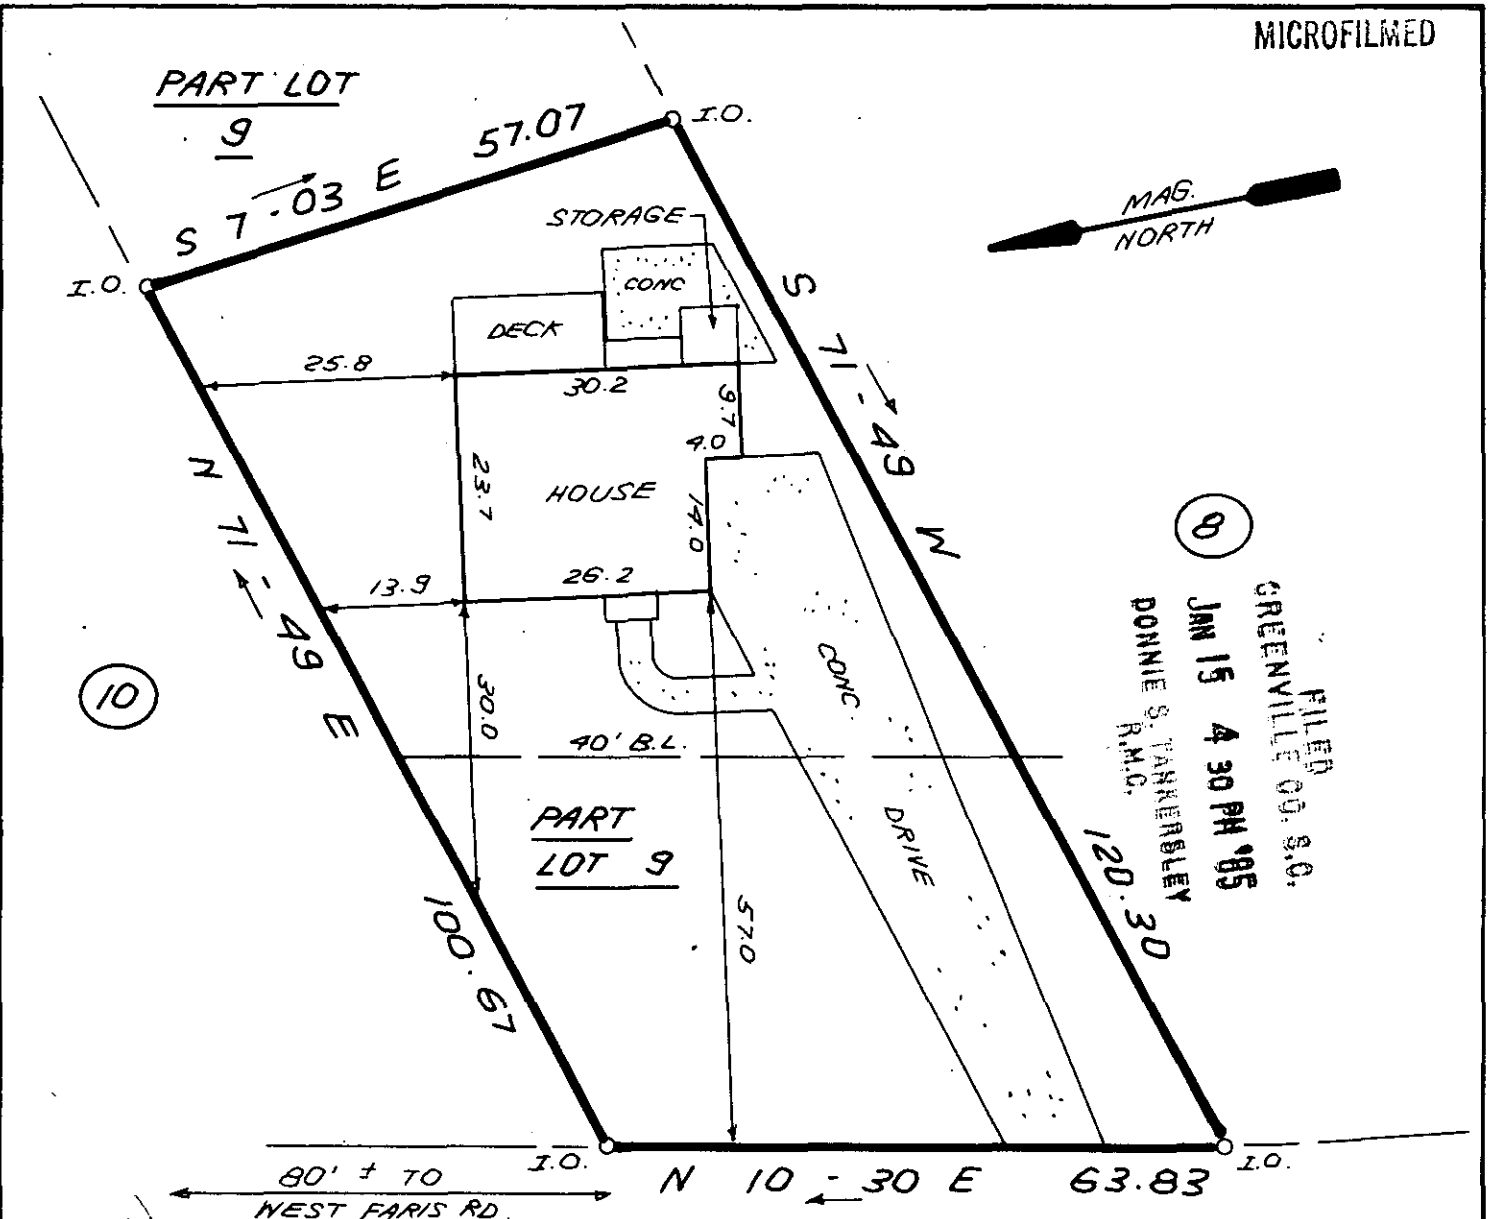


FILED
 GREENVILLE CO. S.C.
 JAN 15 4 30 PM '85
 DONNIE S. TARKERBLEY
 R.M.C. 120.30

10


121053

JAN 15 1985 MOULTRIE ST.
 11-E-42

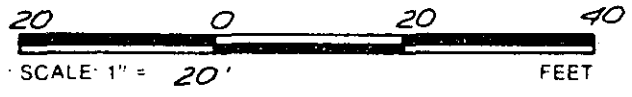

NOTE: 5' DRAINAGE & UTILITY EASEMENT ALONG EACH SIDE OF ALL SIDE & REAR LOT LINES.

THIS IS TO CERTIFY THAT THE PROPERTY SHOWN ON THIS PLAT WAS SURVEYED UNDER MY DIRECT SUPERVISION. PROPERTY LINES AND IMPROVEMENTS SHOWN ARE LOCATED CORRECTLY AND THAT NO VISIBLE ENCROACHMENTS EXIST UNLESS OTHERWISE SHOWN. THIS PROPERTY IS NOT LOCATED IN A DESIGNATED FLOOD HAZARD AREA.

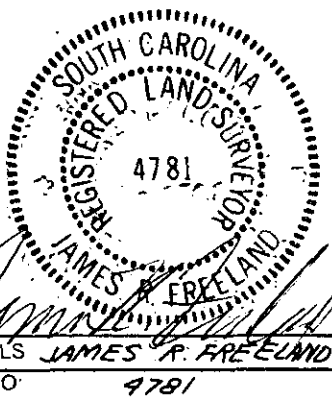

**STATE OF SOUTH CAROLINA
 GREENVILLE COUNTY**

**EDISTO FOREST
 PART LOT 9
 PROPERTY OF
 KENNETH C. CHRISTIANSEN
 DEBORAH J. CHRISTIANSEN &**

FREELAND & ASSOCIATES
 Engineers • Land Surveyors
 318 WEST STONE AVENUE,
 GREENVILLE, S.C.
 (803) 271-4924

PLAT BOOK	9F @ 39
DEED BOOK	1180 @ 530
TAX MAP	221-1-187
PARTY CHIEF	W.B.H. III
DRAWN	K.E.G.
DATE	DEC. 20, 1984
DWG NO	12,249