

13

8

11

12

10



I.O.

I.O.

I.N.

I.O.

S 4 - 06 W 200.0

S 85 - 54 E

N 89 - 20 W 261.2

N 8 - 07 E 50.3

N 10 - 07 E 166.4

NOTE: 5' DRAINAGE & UTILITY EASEMENT ALONG EACH SIDE OF ALL SIDE & REAR LOT LINES.

85.3

79.7

CONC.

55.4

HOUSE

5.4

23.8

5.1

11.3

0.4

4.0

4.0

CONC.

59.2


58.5

50' B.L.

230.2' ± TO HERITAGE LANE

11-E-49

S.C. HWY. 14 (66' R/W)

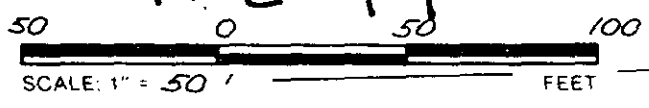


21243 ✓

JAN 17 1985

FILED CO. S.C. GREENVILLE CO. S.C. JAN 17 10 59 AM '85 DONNIE S. TARKERSLEY

THIS IS TO CERTIFY THAT THE PROPERTY SHOWN ON THIS PLAT WAS SURVEYED UNDER MY DIRECT SUPERVISION PROPERTY LINES AND IMPROVEMENTS SHOWN ARE LOCATED CORRECTLY AND THAT NO VISIBLE ENCROACHMENTS EXIST UNLESS OTHERWISE SHOWN. THIS PROPERTY IS NOT LOCATED IN A DESIGNATED FLOOD HAZARD AREA

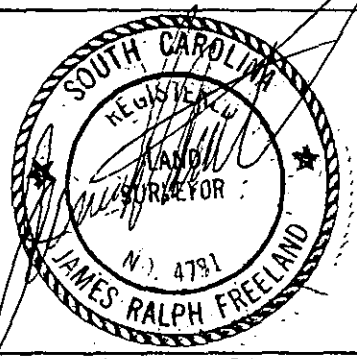

RLS: JAMES R. FREELAND NO: 4781

STATE OF SOUTH CAROLINA GREENVILLE COUNTY

HERITAGE GLEN SEC. 1 ; LOT II PROPERTY OF JOSEPH HOOK & HARRIETT HOOK

FREELAND & ASSOCIATES Engineers • Land Surveyors 318 WEST STONE AVENUE. GREENVILLE, S.C. (803) 271-4924

PLAT BOOK	700 93
DEED BOOK	
TAX MAP	
PARTY CHIEF	J.C.
DRAWN	K.E.G.
DATE	JAN. 16, 1985
DWG NO	12342