
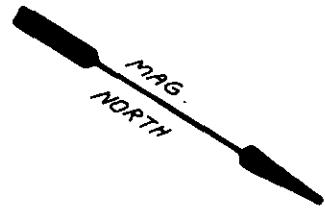


FILED
GREENVILLE CO. S.C.

JAN 28 3 01 PM '85

DONNIE S. TANKERSLEY
R.M.C.

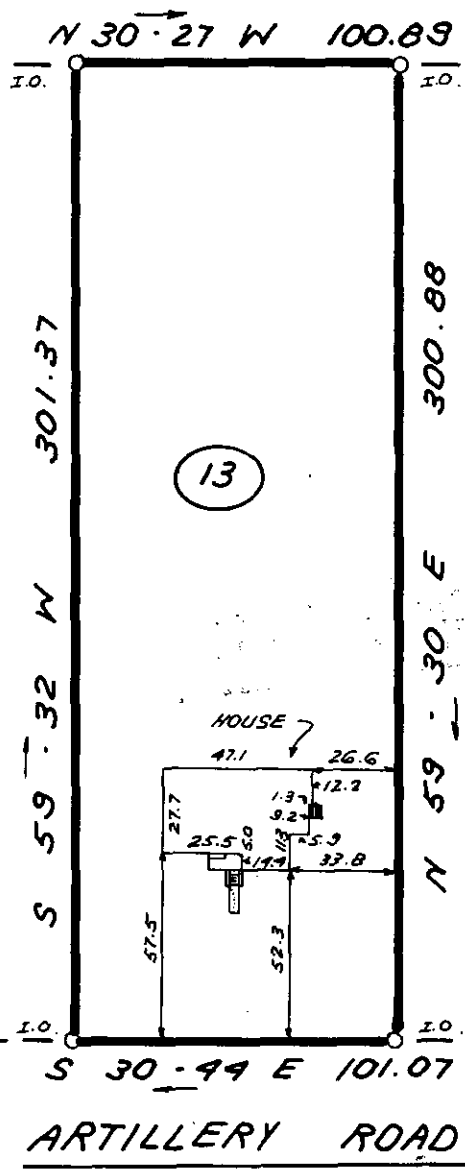

14

12

575' ± TO
U.S. HWY # 29

22214

JUN 23 1985

11-E-86



THIS IS TO CERTIFY THAT THE PROPERTY SHOWN ON THIS PLAT WAS SURVEYED UNDER MY DIRECT SUPERVISION. PROPERTY LINES AND IMPROVEMENTS SHOWN ARE LOCATED CORRECTLY AND THAT NO VISIBLE ENCROACHMENTS EXIST UNLESS OTHERWISE SHOWN. THIS PROPERTY IS NOT LOCATED IN A DESIGNATED FLOOD HAZARD AREA.

**STATE OF SOUTH CAROLINA
GREENVILLE COUNTY**

FREELAND & ASSOCIATES
Engineers • Land Surveyors
318 WEST STONE AVENUE.
GREENVILLE, S.C.
(803) 271-4924

ROBERT J. EDWARDS PROP.
LOT 13
PROPERTY OF
J. G. TIHANYI

PLAT BOOK
DEED BOOK 1205 - 381
TAX MAP P 15.3 - 6 - 27
PARTY CHIEF B.G.
DRAWN K.E.G.
DATE JUNE 27, 1984
DWG. NO. 11379

NO: 4781

2 JAN 28 1985 279

3.000