

MORGAN N/F
1-3-8

S 69-16 E 139.55

BUILDING

BUILDING CORNER

10' IN CONC.

CONC. WALK

89.05

10853 SQ. FT.

BUILDING

WATERS N/F
1-3-6

ALLEY

N 21-29 E 76.50

S 20-45 W 78.50

SOUTH MAIN STREET

BUILDING CORNER

N 68-27 W 140.54

10' IN CONC.

OVERHANG

WEST M^CBEE AVENUE




THIS IS TO CERTIFY THAT THE PROPERTY SHOWN ON THIS PLAT WAS SURVEYED UNDER MY DIRECT SUPERVISION. PROPERTY LINES AND IMPROVEMENTS SHOWN ARE LOCATED CORRECTLY AND THAT NO VISIBLE ENCROACHMENTS EXIST UNLESS OTHERWISE SHOWN. THIS PROPERTY IS NOT LOCATED IN A DESIGNATED FLOOD HAZARD AREA.

FILED
GREENVILLE CO. S.C.
JAN 9 2 47 PM '85
DONNIE S. TANKERSLEY
R.H.C.

20454 ✓

11-F-7

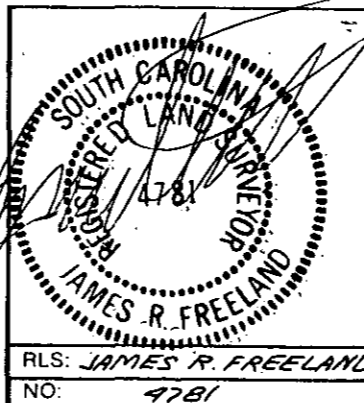

STATE OF SOUTH CAROLINA
GREENVILLE COUNTY

FREELAND & ASSOCIATES
Engineers • Land Surveyors
318 WEST STONE AVENUE.
GREENVILLE, S.C.
(803) 271-4924

SURVEY FOR
BERKELEY LOANS, INC.

GCTS -- 3 JA • 9 85

PLAT BOOK
DEED BOOK 692-02
TAX MAP 1-3-7
PARTY CHIEF L.T.
DRAWN K.E.G.
DATE 5 AUG. 29, 1984
DWG. NO. 11,688

MICROFILMED

THE PRINT MACHINE, INC. N41289