


FILED
GREENVILLE CO. S.C.

FEB 20 1 31 PM '85


DONNIE S. TANKERSLEY
R.M.C.

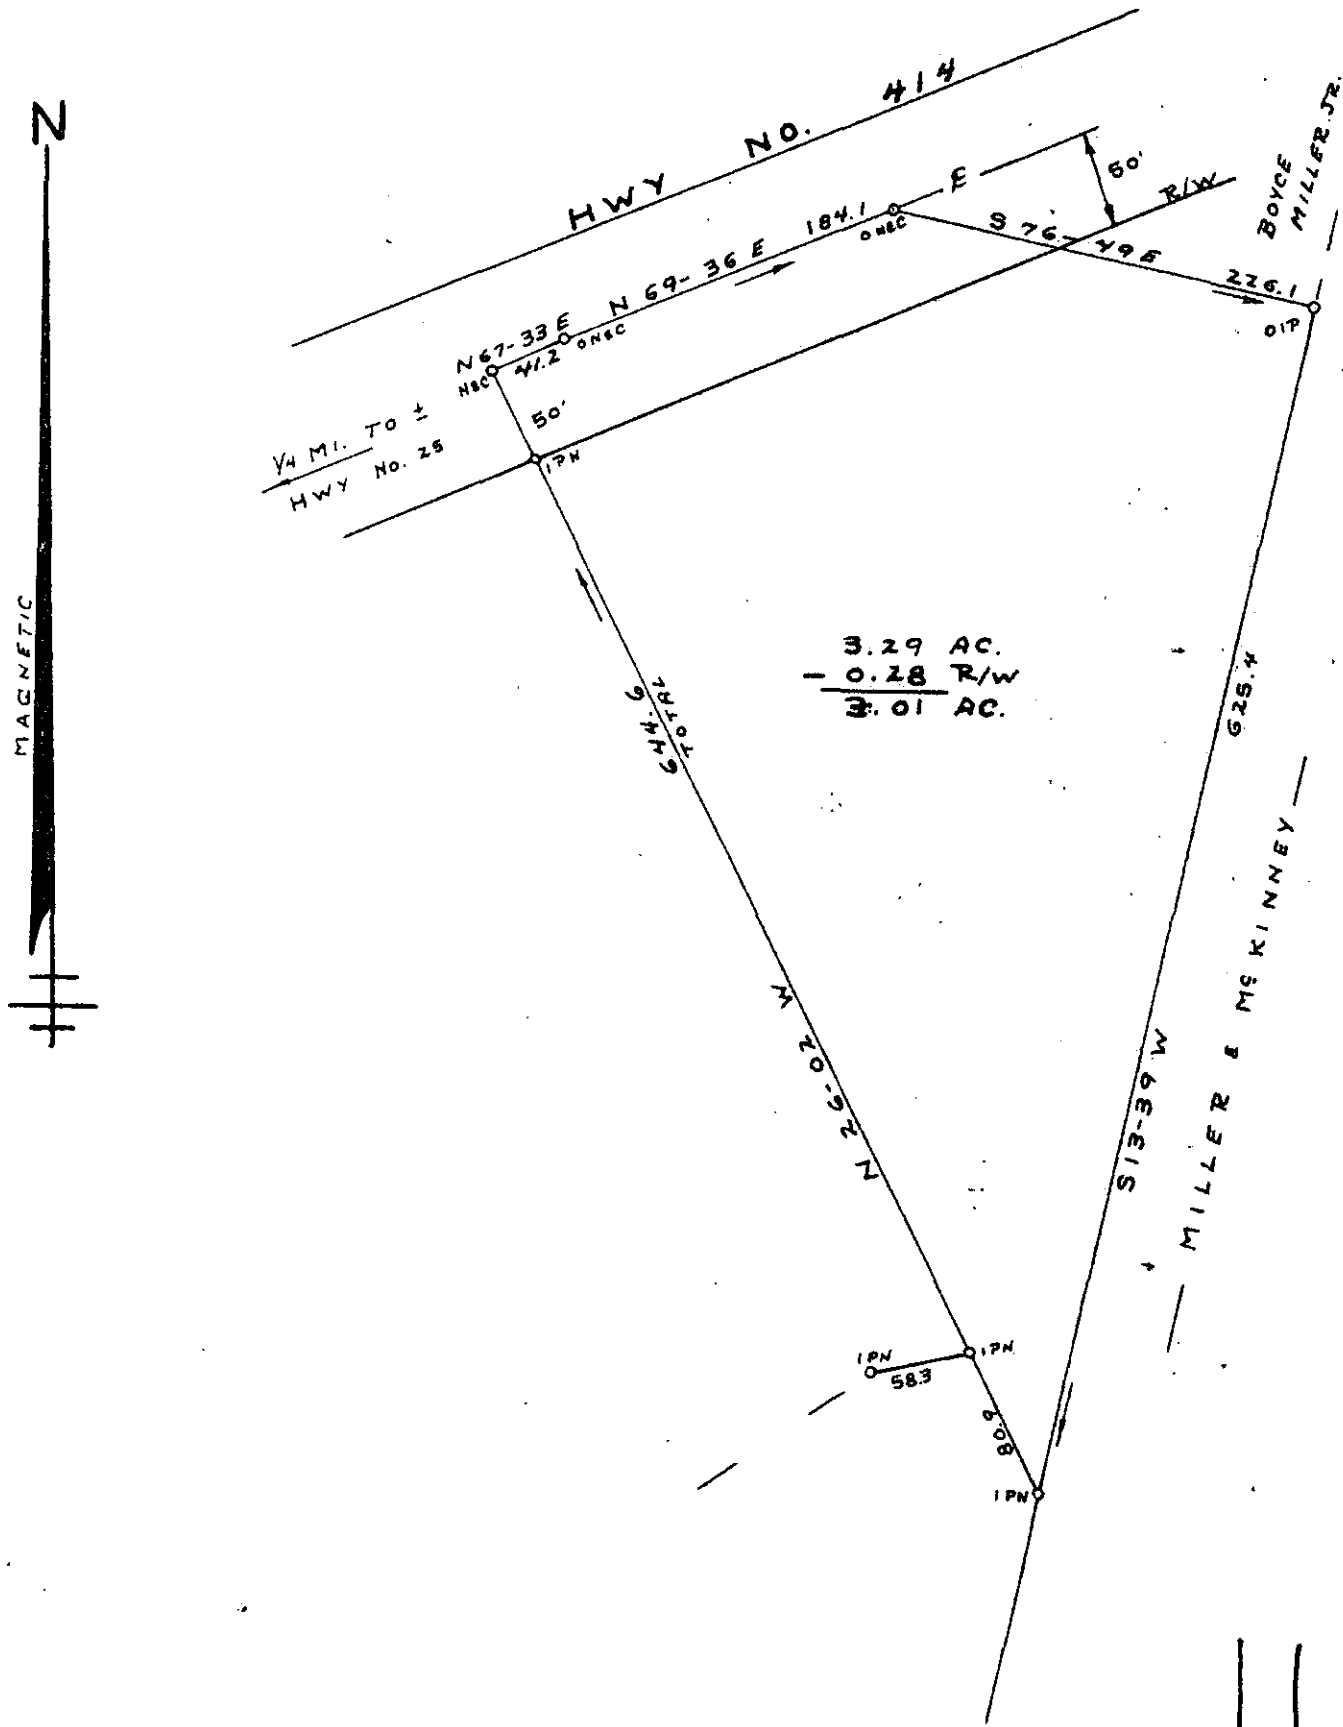

11F-52

SURVEY FOR FEB 20 1985
 TONY R. STYLES
 JEAN G. STYLES ✓ 24568
 NEAR TRAVELERS REST GREENVILLE CO.
 SOUTH CAROLINA
 FEB 12, 1985

5210-1-EE20-85 019


JEFFERY M. PLUMBLEE, INC.
 LAND SURVEYING
 P O BOX 788
 TRAVELERS REST, S C 29690 (803) 834-4426

I Hereby Certify That The Ratio Of Precision
 Of The Field Survey Is 1/5200 As
 Shown Hereon And The Area Was Determined
 By D.M.D. Method
 Jeffery M. Plumblee
 P.O. Box 788
 Greenville, S.C. 29690

