
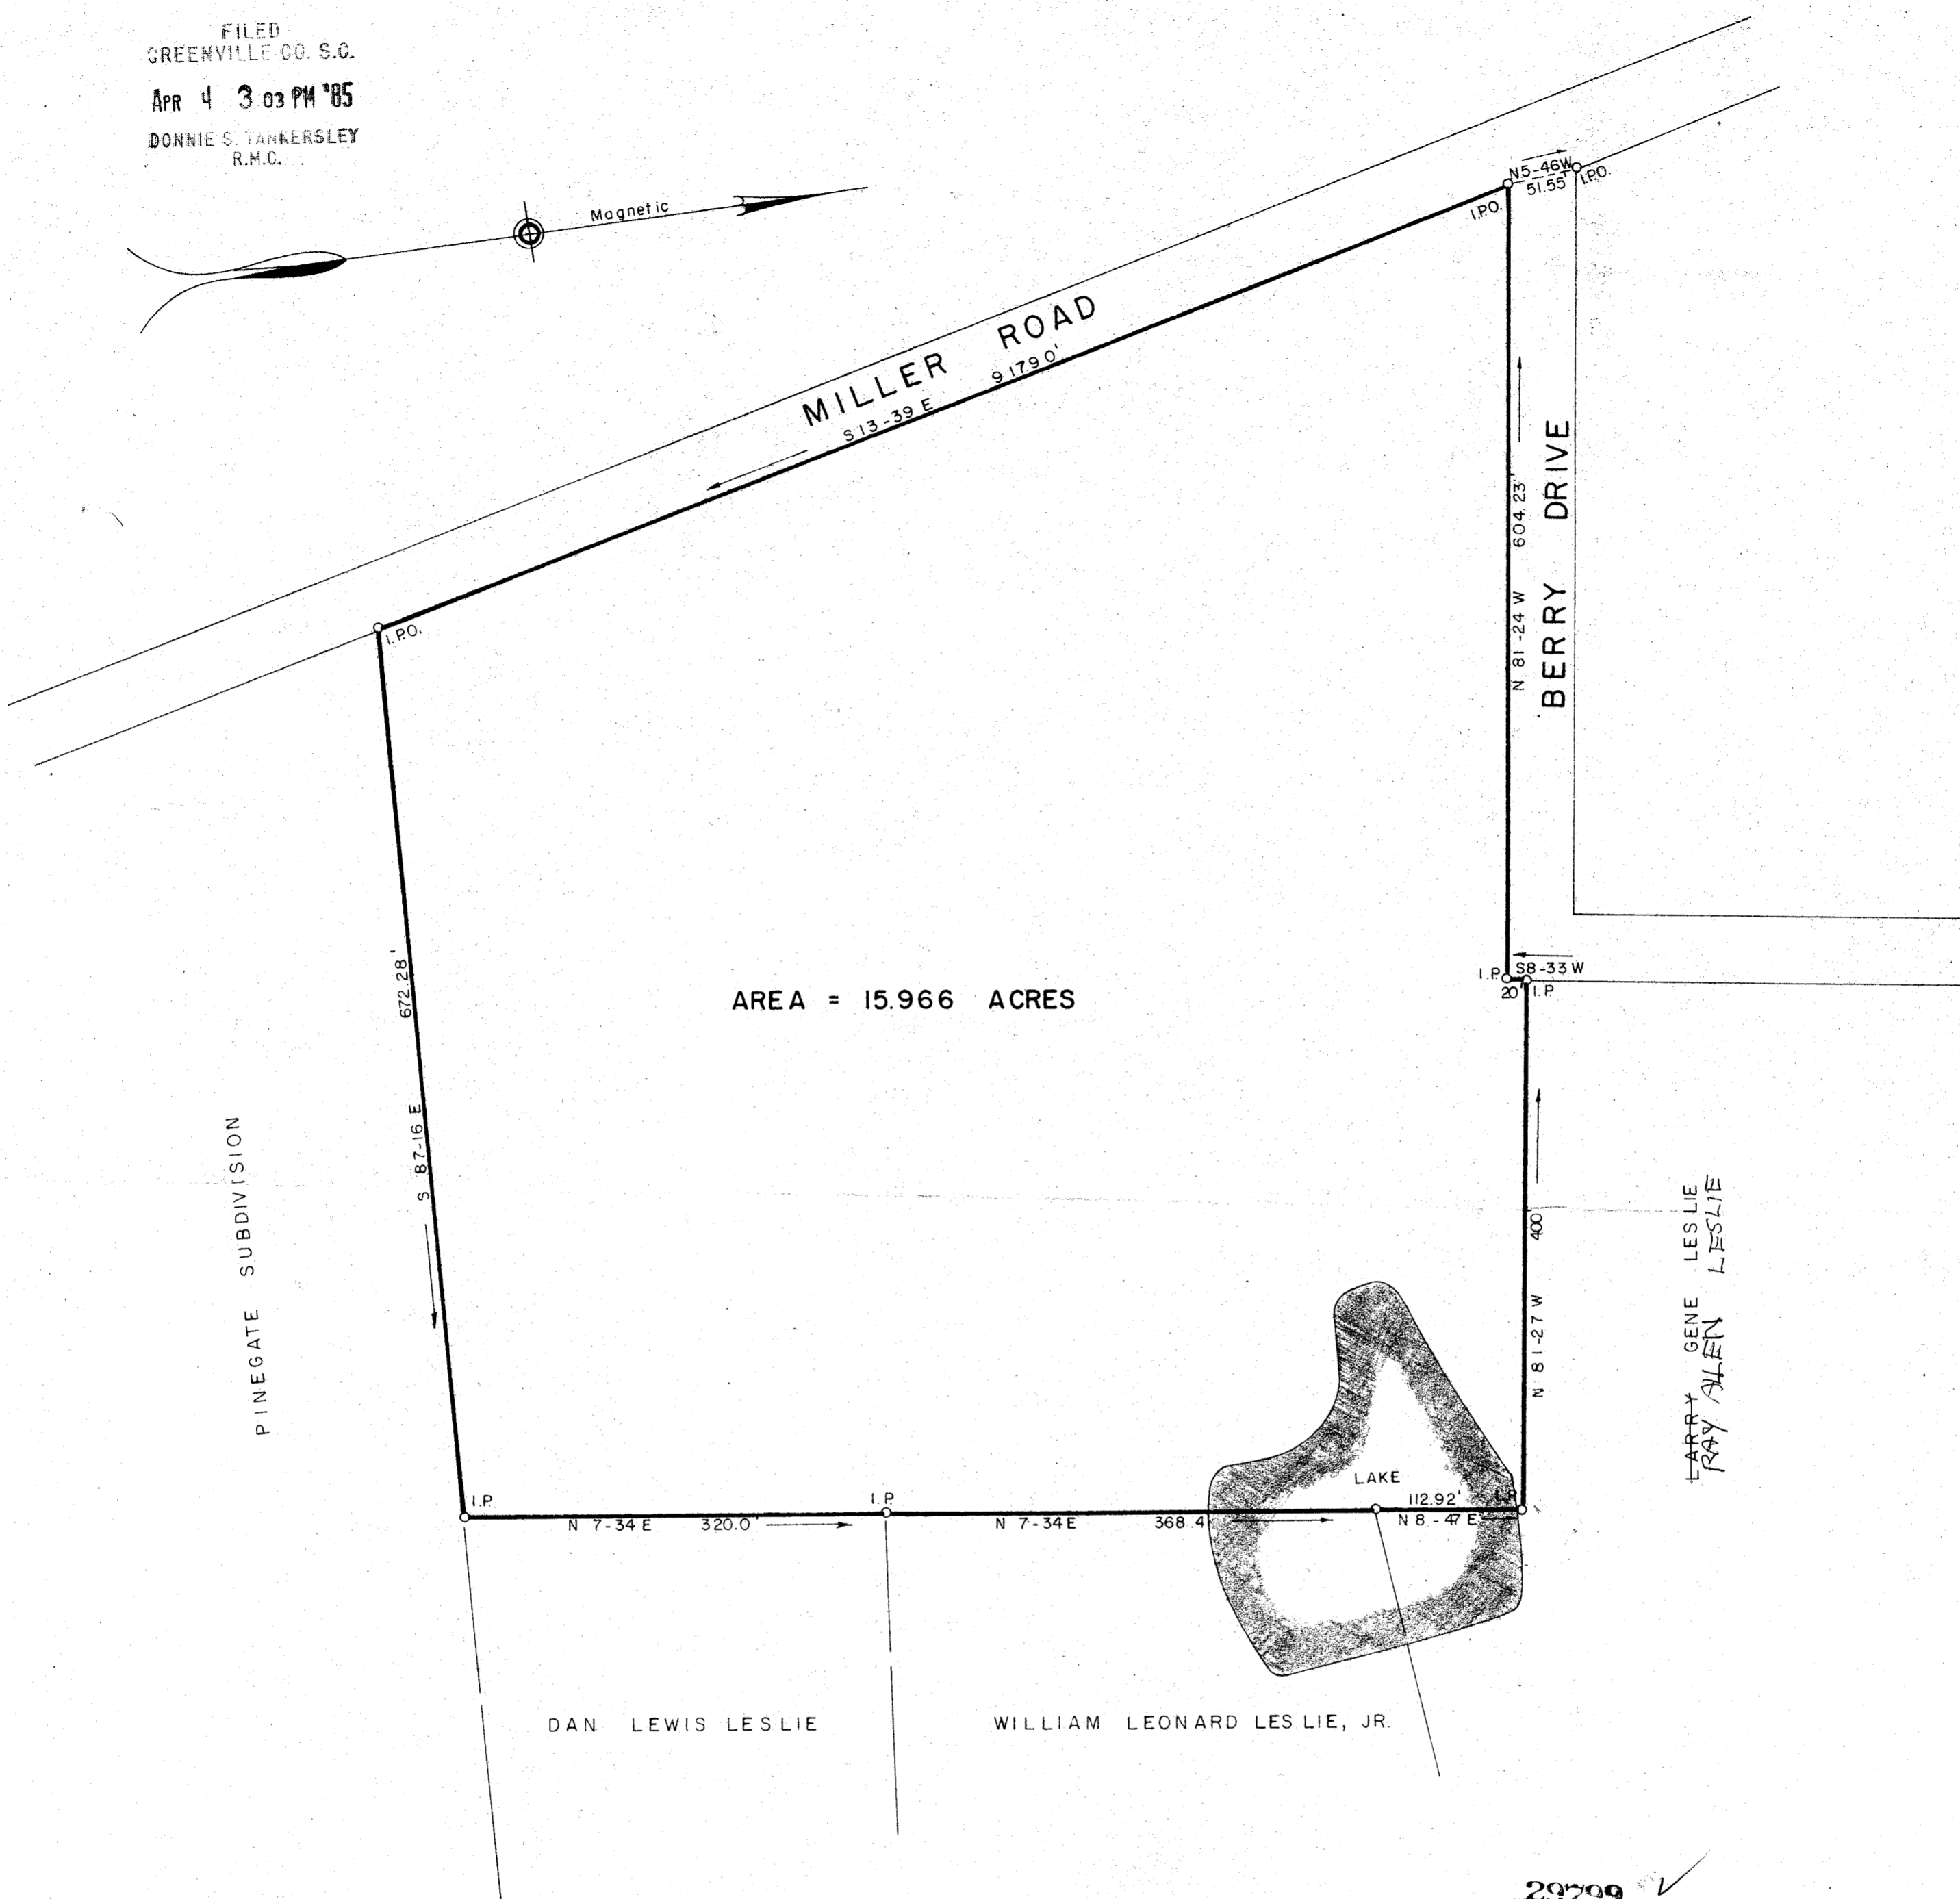


FILED
GREENVILLE CO. S.C.
APR 4 3 03 PM '85
DONNIE S. TANKERSLEY
R.M.C.

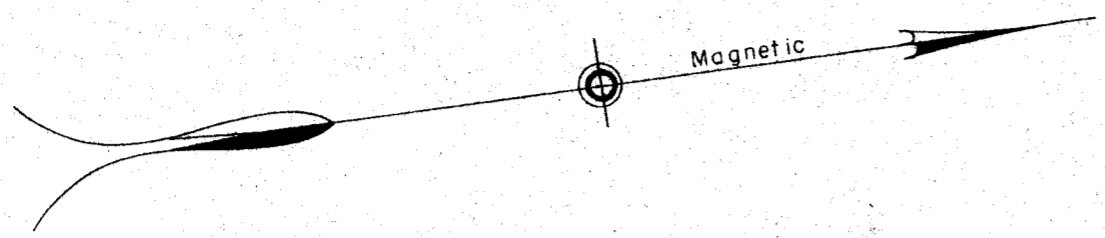

AREA = 15.966 ACRES

PINEGATE SUBDIVISION


HARRY GENE LESLIE
RAY ALLEN LESLIE

DAN LEWIS LESLIE WILLIAM LEONARD LESLIE, JR.

PROPERTY OF
W. L. LESLIE
GREENVILLE COUNTY, S.C.

Scale 1" = 100' October, 1984
DALTON & NEVES CO, INC. ENGINEERS
121 MANLY STREET
GREENVILLE, S.C.

29799 ✓
11-G-71
APR 4 1985

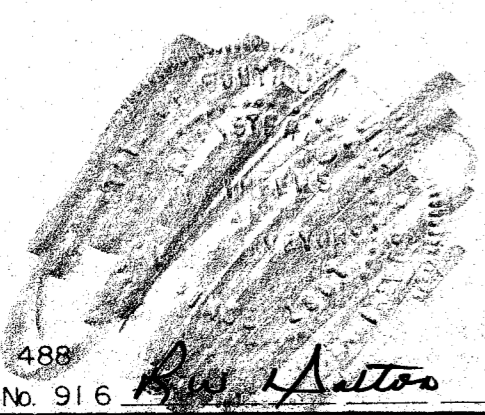

5.000
F.B. 487, 488
S.C. Reg. No. 916