MICROFILMED

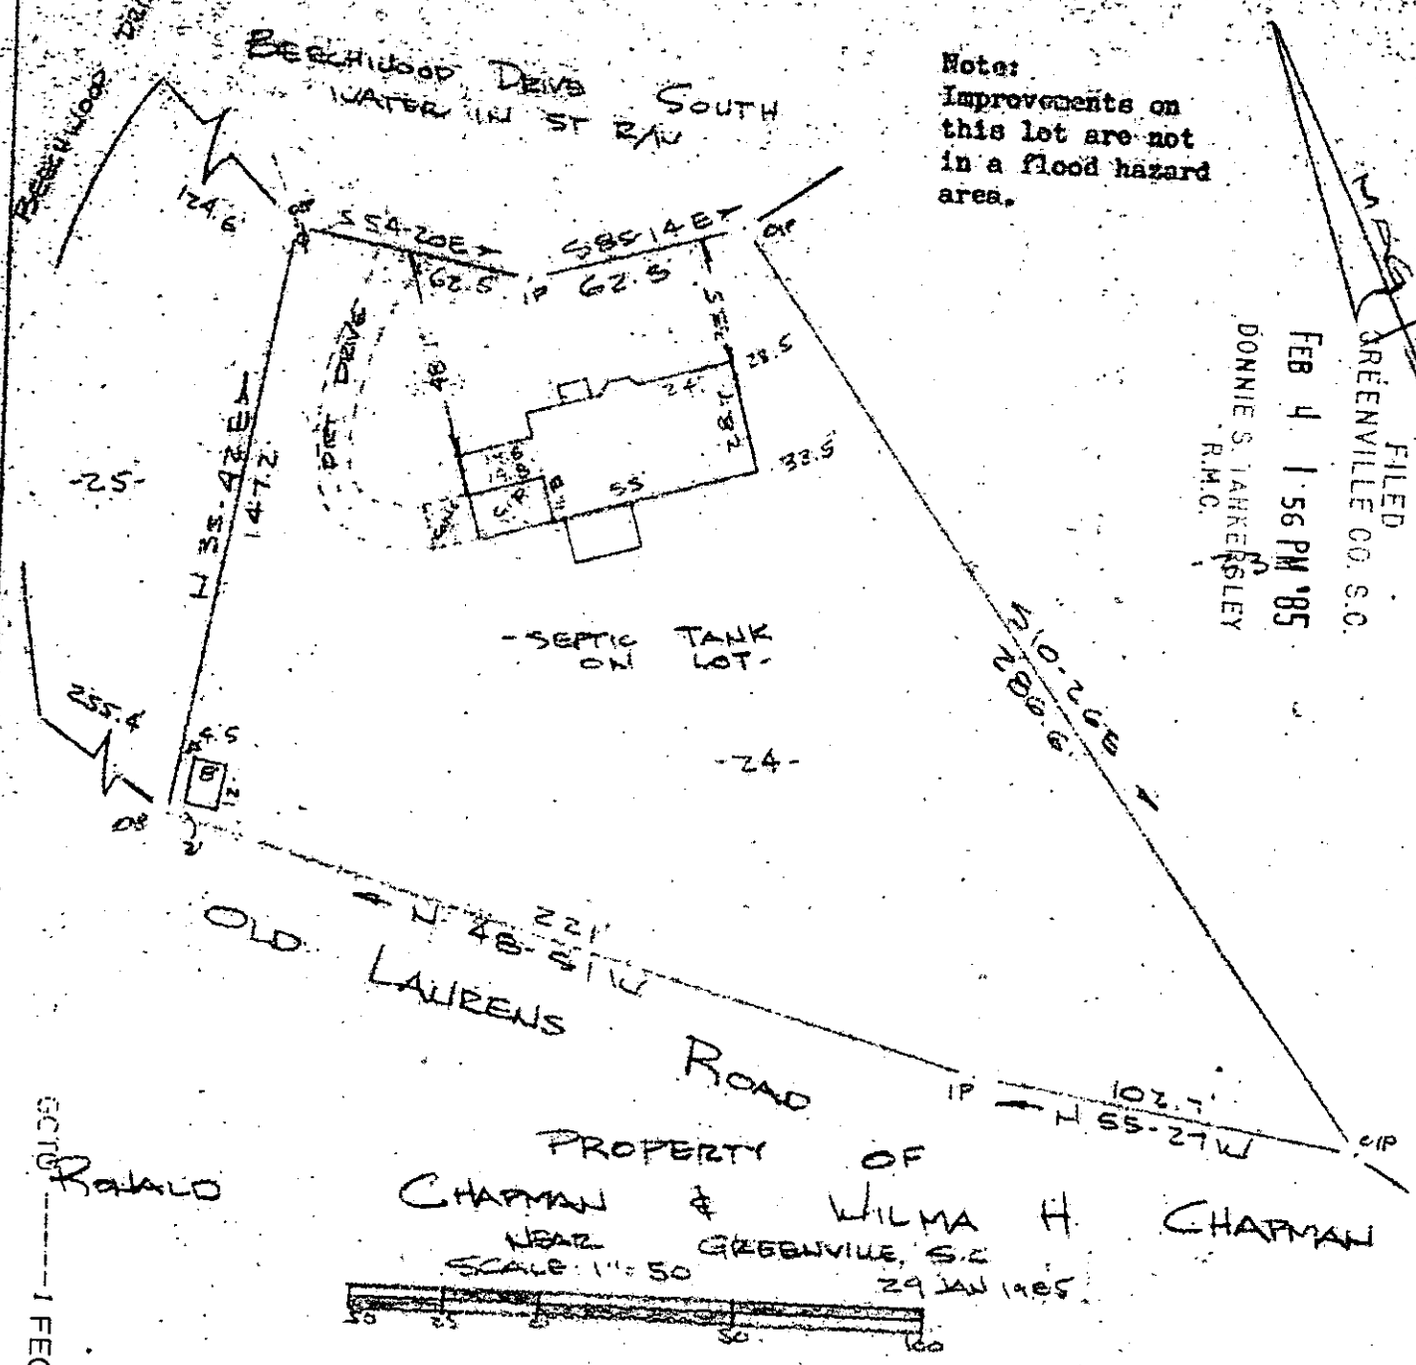

Note:
Improvements on this lot are not in a flood hazard area.

MAP 1958

FILED
GREENVILLE CO. S.C.
FEB 4 1 56 PM '85
DONNIE S. TANKERSLEY
R.M.C.


1 FEB04 85 050

This is to certify that on the 29th day of January, 1985, I surveyed the property shown on this plat, being known as MAP OF BEECHWOOD HILLS and recorded in the RMC Office Greenville County, S. C., in Plat Book " QQ " at Page 35; and that the property lines, walls and buildings are as shown hereon, and that the walls and buildings located on said lot do not encroach or project on adjacent street or property, and that no adjacent walls or buildings encroach or project on said premises, and no power lines cross this property except as shown hereon.

FEB 4 1985

11-H-13

22964

3.0000

R. B. Bruce

CAROLINA SURVEYING CO.
112 Manly St.
Greenville, S. C.

R. B. Bruce, RLS # 1952

Recordable Plat

282/43

295. -1-29