MICROFILMED

FILED
GREENVILLE CO. S.C.
FEB 6 4 47 PM '85
DONNIE S. TANKERSLEY
R.M.C.

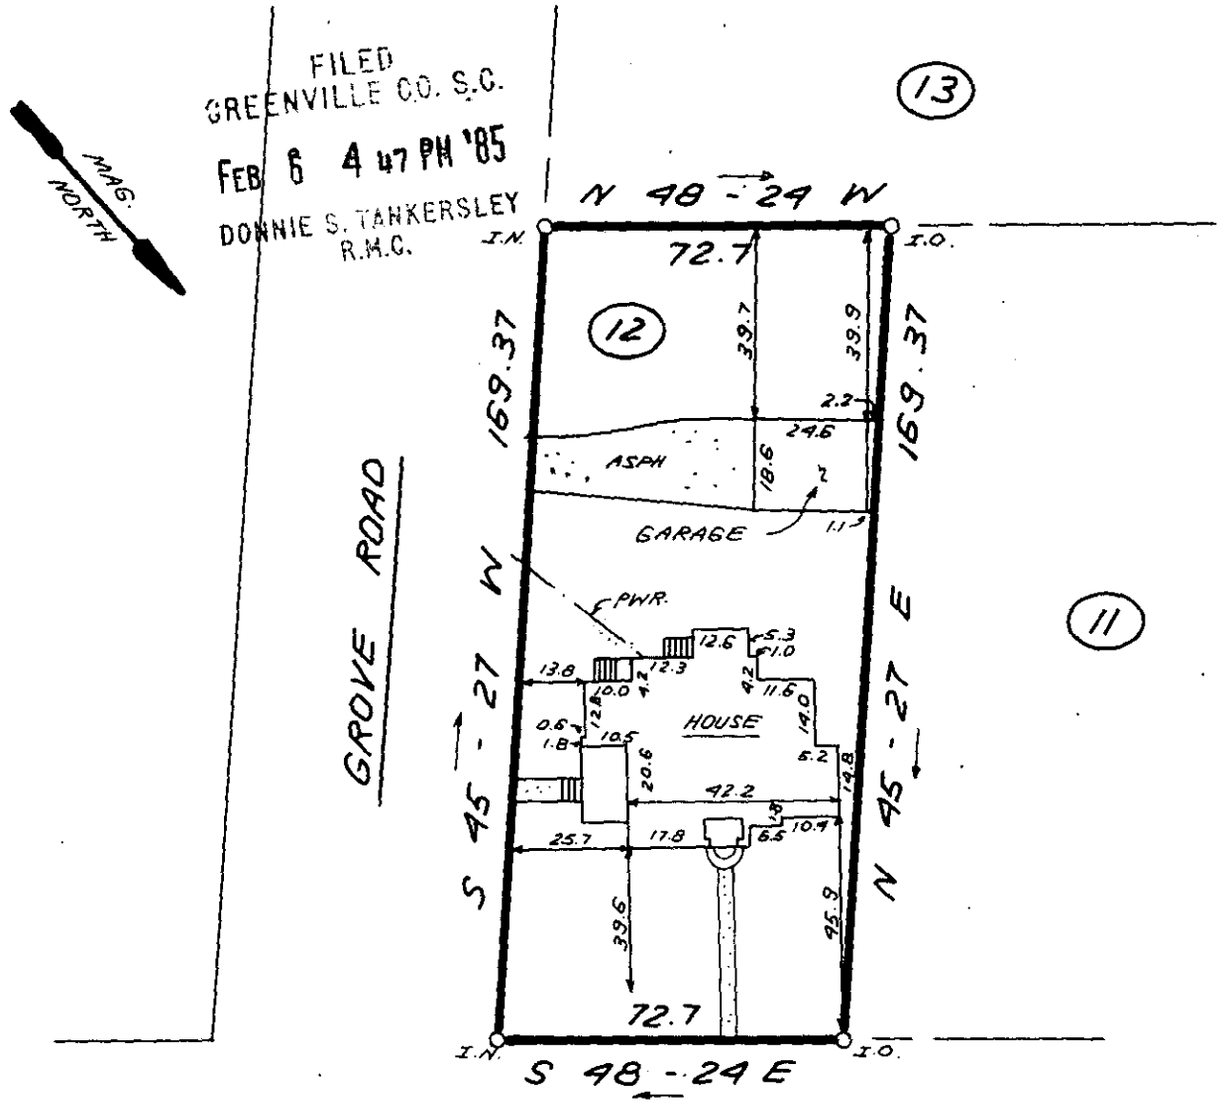

AUGUSTA ROAD

FEB 6 1985

23316

11-H-23

40 0 40 80

SCALE: 1" = 40' FEET

THIS IS TO CERTIFY THAT THE PROPERTY SHOWN ON THIS PLAT WAS SURVEYED UNDER MY DIRECT SUPERVISION. PROPERTY LINES AND IMPROVEMENTS SHOWN ARE LOCATED CORRECTLY AND THAT NO VISIBLE ENCROACHMENTS EXIST UNLESS OTHERWISE SHOWN THIS PROPERTY IS NOT LOCATED IN A DESIGNATED FLOOD HAZARD AREA

SOUTH CAROLINA REGISTERED LAND SURVEYOR 4781 JAMES R. FREELAND

PLS: JAMES R. FREELAND
NO: 4781

STATE OF SOUTH CAROLINA
GREENVILLE COUNTY

O. P. MILLS
BLOCK M; LOT 12
PROPERTY OF
W. E. HENDERSON, JR.

FEB 6 85

FREELAND & ASSOCIATES
Engineers • Land Surveyors
318 WEST STONE AVENUE.
GREENVILLE. S.C.
(803) 271-4924

PLAT BOOK	C - 176
DEED BOOK	117 - 224
TAX MAP	96 - 7 - 1
PARTY CHIEF	R.S.A.
DRAWN	K.E.G.
DATE	JAN. 31, 1985
DWG. NO.	12,906

THE PRINT MACHINE, INC. N48640