


MICROFILMED

FILED
GREENVILLE CO. S.C.

FEB 14 3 49 PM '85

DONNIE S. TANKERSLEY
R.M.C.

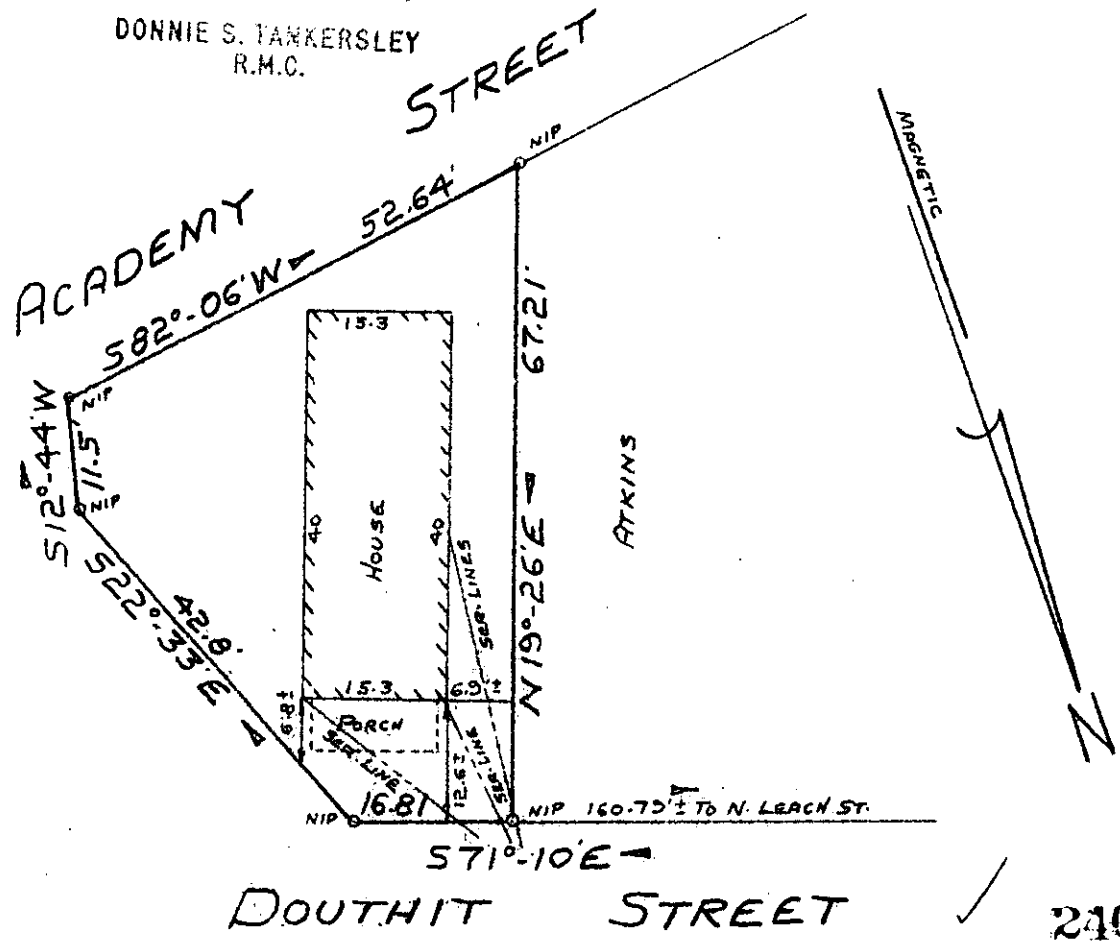

DOUTHIT STREET ✓ 24009

PROPERTY OF

JAMES BOOZER
GREENVILLE, GREENVILLE CO., SOUTH CAROLINA
JAN 9, 1985

11-H-43

FEB 14 1985

SCALE 1"=20'

ECTO -----1 FE14 85 032

This is to certify that on January 9, 1985, I surveyed the property shown on this plat known as Property of James Boozer as recorded in the RMC Office for Greenville County in Plat Book , Page , and that the property lines, walls and buildings are as shown hereon, and that the building located on said lot does not project nor encroach on adjacent streets or property, and that no adjacent walls or buildings project nor encroach on said lot, and that no utility lines cross this lot except as may be shown hereon. The degree of accuracy is 1/8,000.

NOTE: This property is not located within a flood hazard area.

Surveyed by: Richard D. Wooten, Jr.
Greenville, South Carolina

Richard D. Wooten, Jr.
S. C. R. L. S. No. 4678

References: Tax Map Sheet 78-6-18
Deed Book 28 Page 224

3.0000