

EASTVIEW HIGHTS

FILED  
GREENVILLE CO. S.C.

FEB 22 3 05 PM '85


DONNIE S. TANKERSLEY  
R.M.C.



52

53

54

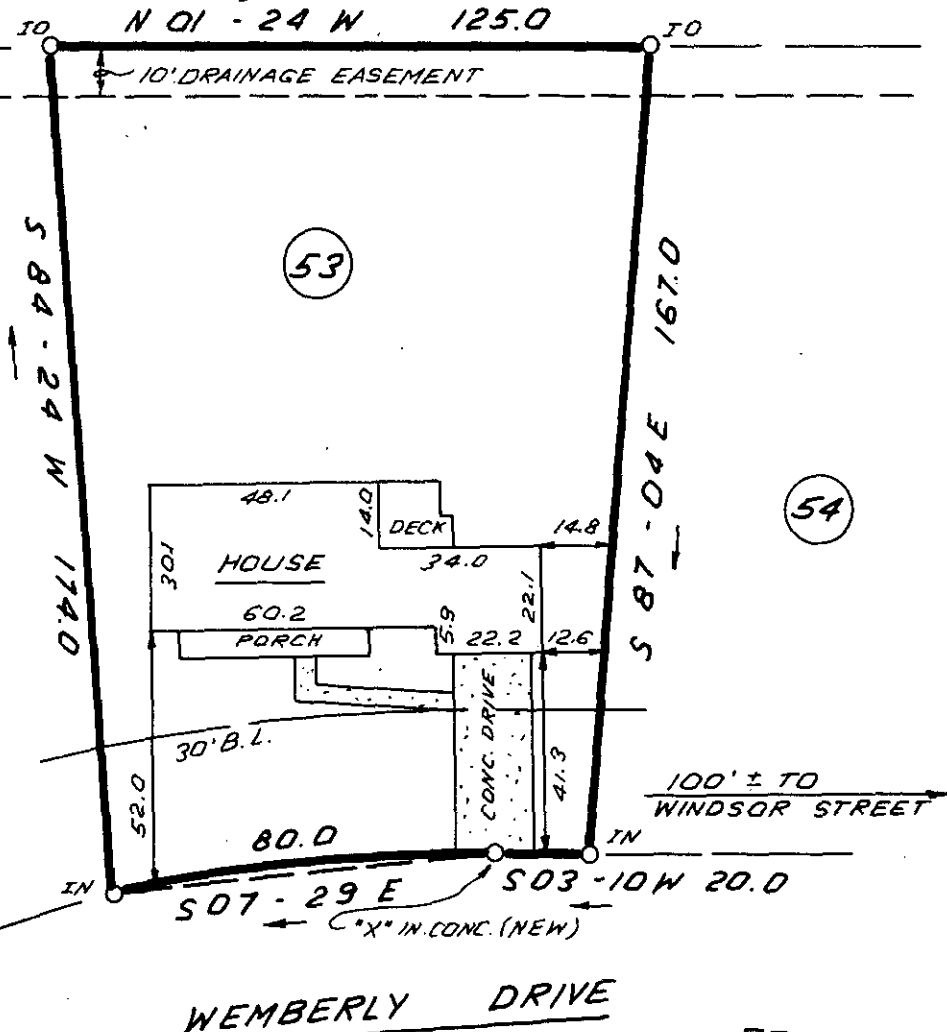

FEB 22 1985

11-H-68  
24856



THIS IS TO CERTIFY THAT THE PROPERTY SHOWN ON THIS PLAT WAS SURVEYED UNDER MY DIRECT SUPERVISION. PROPERTY LINES AND IMPROVEMENTS SHOWN ARE LOCATED CORRECTLY AND THAT NO VISIBLE ENCROACHMENTS EXIST UNLESS OTHERWISE SHOWN. THIS PROPERTY IS NOT LOCATED IN A DESIGNATED FLOOD HAZARD AREA.

STATE OF SOUTH CAROLINA  
GREENVILLE COUNTY

FREELAND & ASSOCIATES  
Engineers • Land Surveyors  
318 WEST STONE AVENUE.  
GREENVILLE, S.C.  
(803) 271-4924

WEMBERLY WAY  
SEC. 2, LOT 53  
PROPERTY OF  
DAVID M. PRESSLEY  
TRACY S. PRESSLEY

PLAT BOOK	7C-39
DEED BOOK	1150-348
TAX MAP	318.3-1-25
PARTY CHIEF	J.C.
DRAWN	I.R.
DATE	2-21-85
DWG. NO.	12494



RLS: JAMES R. FREELAND  
NO: 4781