MICROFILMED

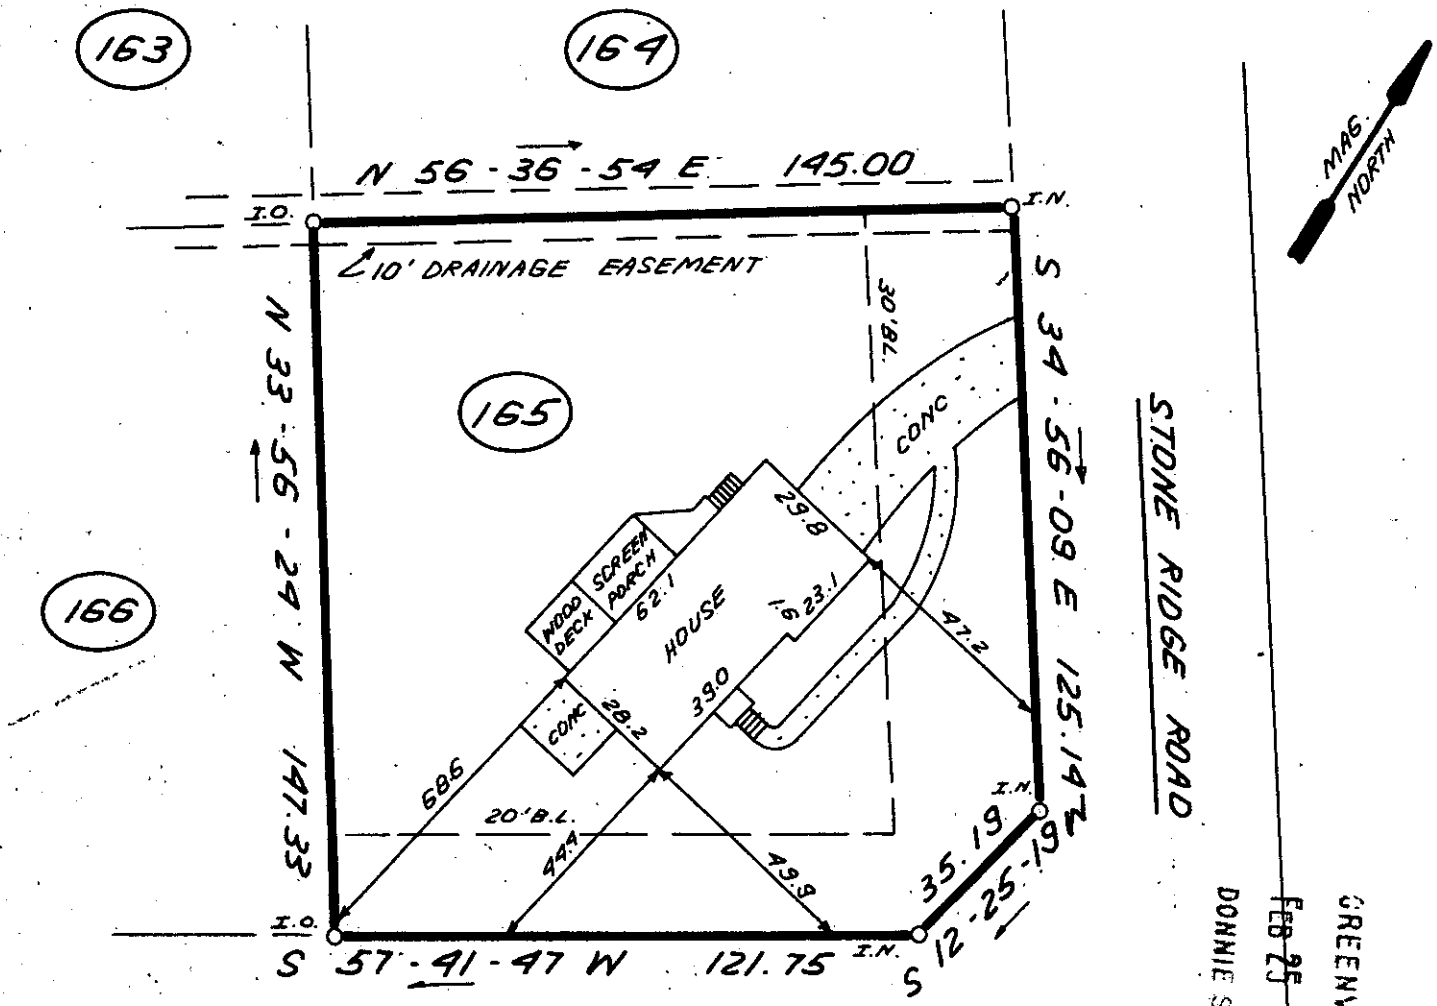

FILED
GREENVILLE CO. S.C.
FEB 25 12 42 PM '85
DONNIE S. TANKERSLEY
R.M.C.

11-4-11

24989

FEB 25 1985

40 0 40 80

SCALE: 1" = 40' FEET

NOTE:
5' DRAINAGE & UTILITIES EASEMENT EACH SIDE OF ALL SIDE & REAR LOT LINES.

THIS IS TO CERTIFY THAT THE PROPERTY SHOWN ON THIS PLAT WAS SURVEYED UNDER MY DIRECT SUPERVISION. PROPERTY LINES AND IMPROVEMENTS SHOWN ARE LOCATED CORRECTLY AND THAT NO VISIBLE ENCROACHMENTS EXIST UNLESS OTHERWISE SHOWN. THIS PROPERTY IS NOT LOCATED IN A DESIGNATED FLOOD HAZARD AREA.

SOUTH CAROLINA REGISTERED PROFESSIONAL LAND SURVEYOR NO. 4781

RLS: JAMES H. FREELAND
NO: 4781

STATE OF SOUTH CAROLINA
GREENVILLE COUNTY

SUGAR CREEK
MAP 2, SEC. 1, LOT 165
PROPERTY OF
WAYNE E. PUNCH
MARGARET W. PUNCH

3 FEB 25 85 939

FREELAND & ASSOCIATES
Engineers • Land Surveyors
318 WEST STONE AVENUE.
GREENVILLE, S.C.
(803) 271-4924

PLAT BOOK	4R@85
DEED BOOK	1051-785
TAX MAP	
PARTY CHIEF	RAJ
DRAWN	KEG
DATE	FEB 21, 1985
DWG. NO.	12498

THE PRINT MACHINE, INC. N53007