MICROFILMED

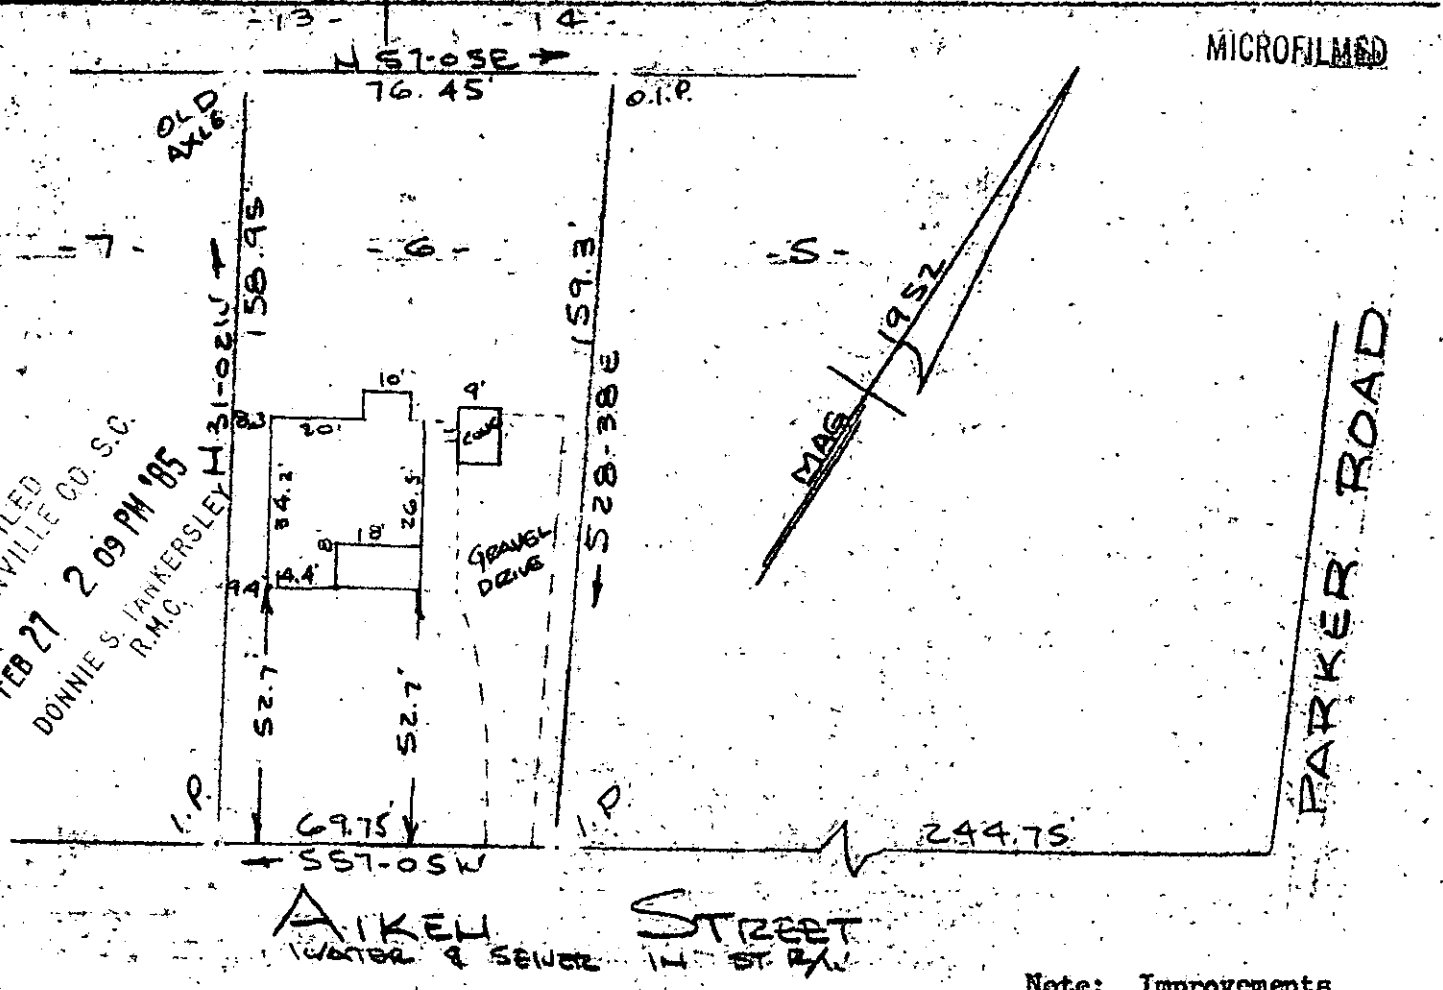

Note: Improvements on this lot are not in a flood hazard area.

11-H-81

FEB 27 1985

25274

PROPERTY OF

JAMES C. MOON & SUSAN A. McINTIRE

HEAD

GREENVILLE, S.C.

SCALE 1" = 40'

SURVEYED FEB 1985

40 20 0 40 80

This is to certify that on the 25th day of February, 1985, I surveyed the property shown on this plat, being known as lot 6 on plat of BEREA REALTY CO. and recorded in the RMC Office Greenville County, S. C., in Plat Book " BB " at Page 37 and also known as PROPERTY OF JAMES C. MOON & SUSAN A. McINTIRE and recorded in Plat Book at Page ; and that the property lines, walls and buildings are as shown hereon, and that the walls and buildings located on said lot do not encroach or project on adjacent street or property, and that no adjacent walls or buildings encroach or project on said premises, and no power lines cross this property except as shown hereon.

R. B. Bruce

R. B. Bruce, RLS # 1952

CAROLINA SURVEYING CO.
112 Manly St.
Greenville, S. C.

Recordable Plat

300 8 1801

288/7A

B131-1-27