




FILED GREENVILLE CO. S.C. SUNBELT PROPERTY

MAR 1 3 11 PM '85

DONNIE S. TANKERSLEY
R.M.C.

N 31 - 30 E
PROPERTY LINE

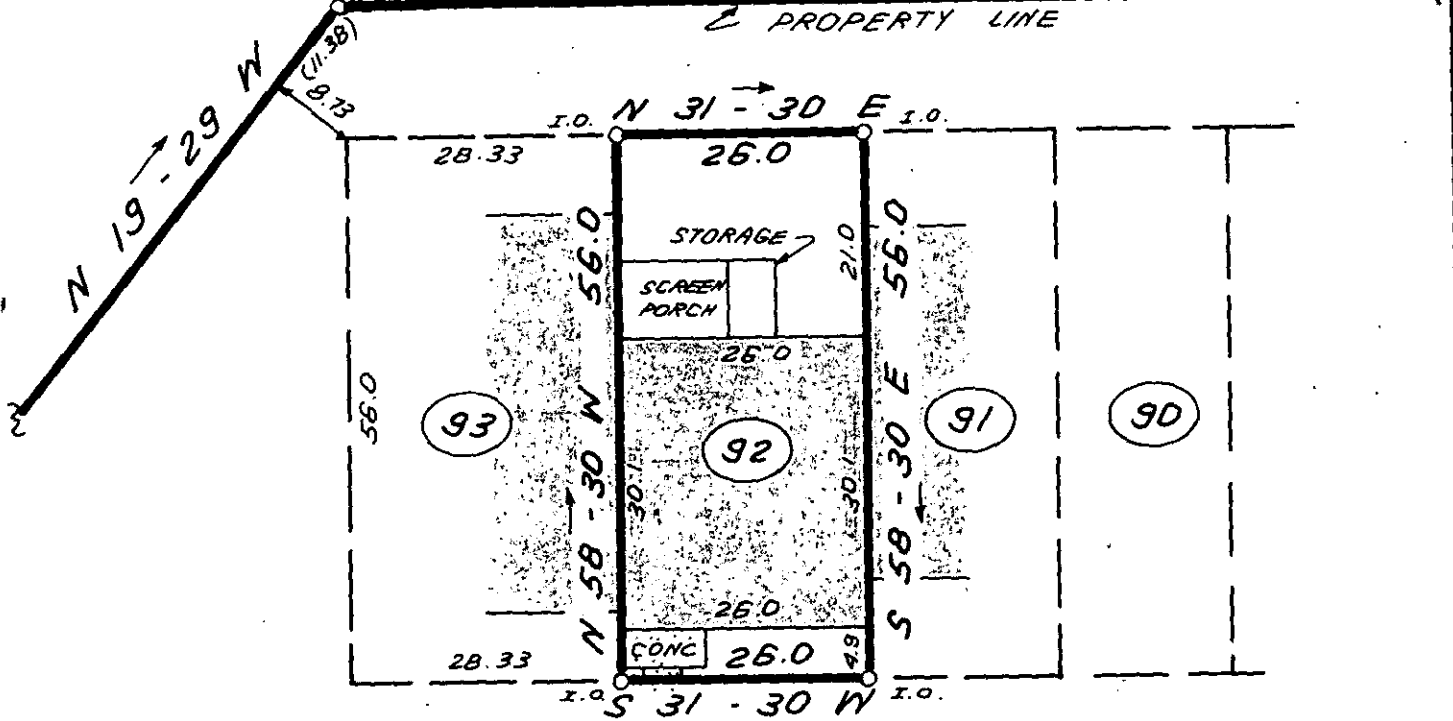

MAR 1 1985

11-H-99

25648



THIS IS TO CERTIFY THAT THE PROPERTY SHOWN ON THIS PLAT WAS SURVEYED UNDER MY DIRECT SUPERVISION. PROPERTY LINES AND IMPROVEMENTS SHOWN ARE LOCATED CORRECTLY AND THAT NO VISIBLE ENCROACHMENTS EXIST UNLESS OTHERWISE SHOWN. THIS PROPERTY IS NOT LOCATED IN A DESIGNATED FLOOD HAZARD AREA.

ECTO ---1 MRO1 85 041

3.0000



**STATE OF SOUTH CAROLINA
GREENVILLE COUNTY**

JAMESTOWNE II
UNIT 92
PROPERTY OF
KEITH R. LITTLE
REBECCA M. LITTLE

FREELAND & ASSOCIATES
Engineers • Land Surveyors
318 WEST STONE AVENUE.
GREENVILLE, S.C.
(803) 271-4924

PLAT BOOK	9W@ 33
DEED BOOK	
TAX MAP	538.20-1-31
PARTY CHIEF	J.C.
DRAWN	K.E.G.
DATE	FEB. 13, 1985
DWG. NO.	12479