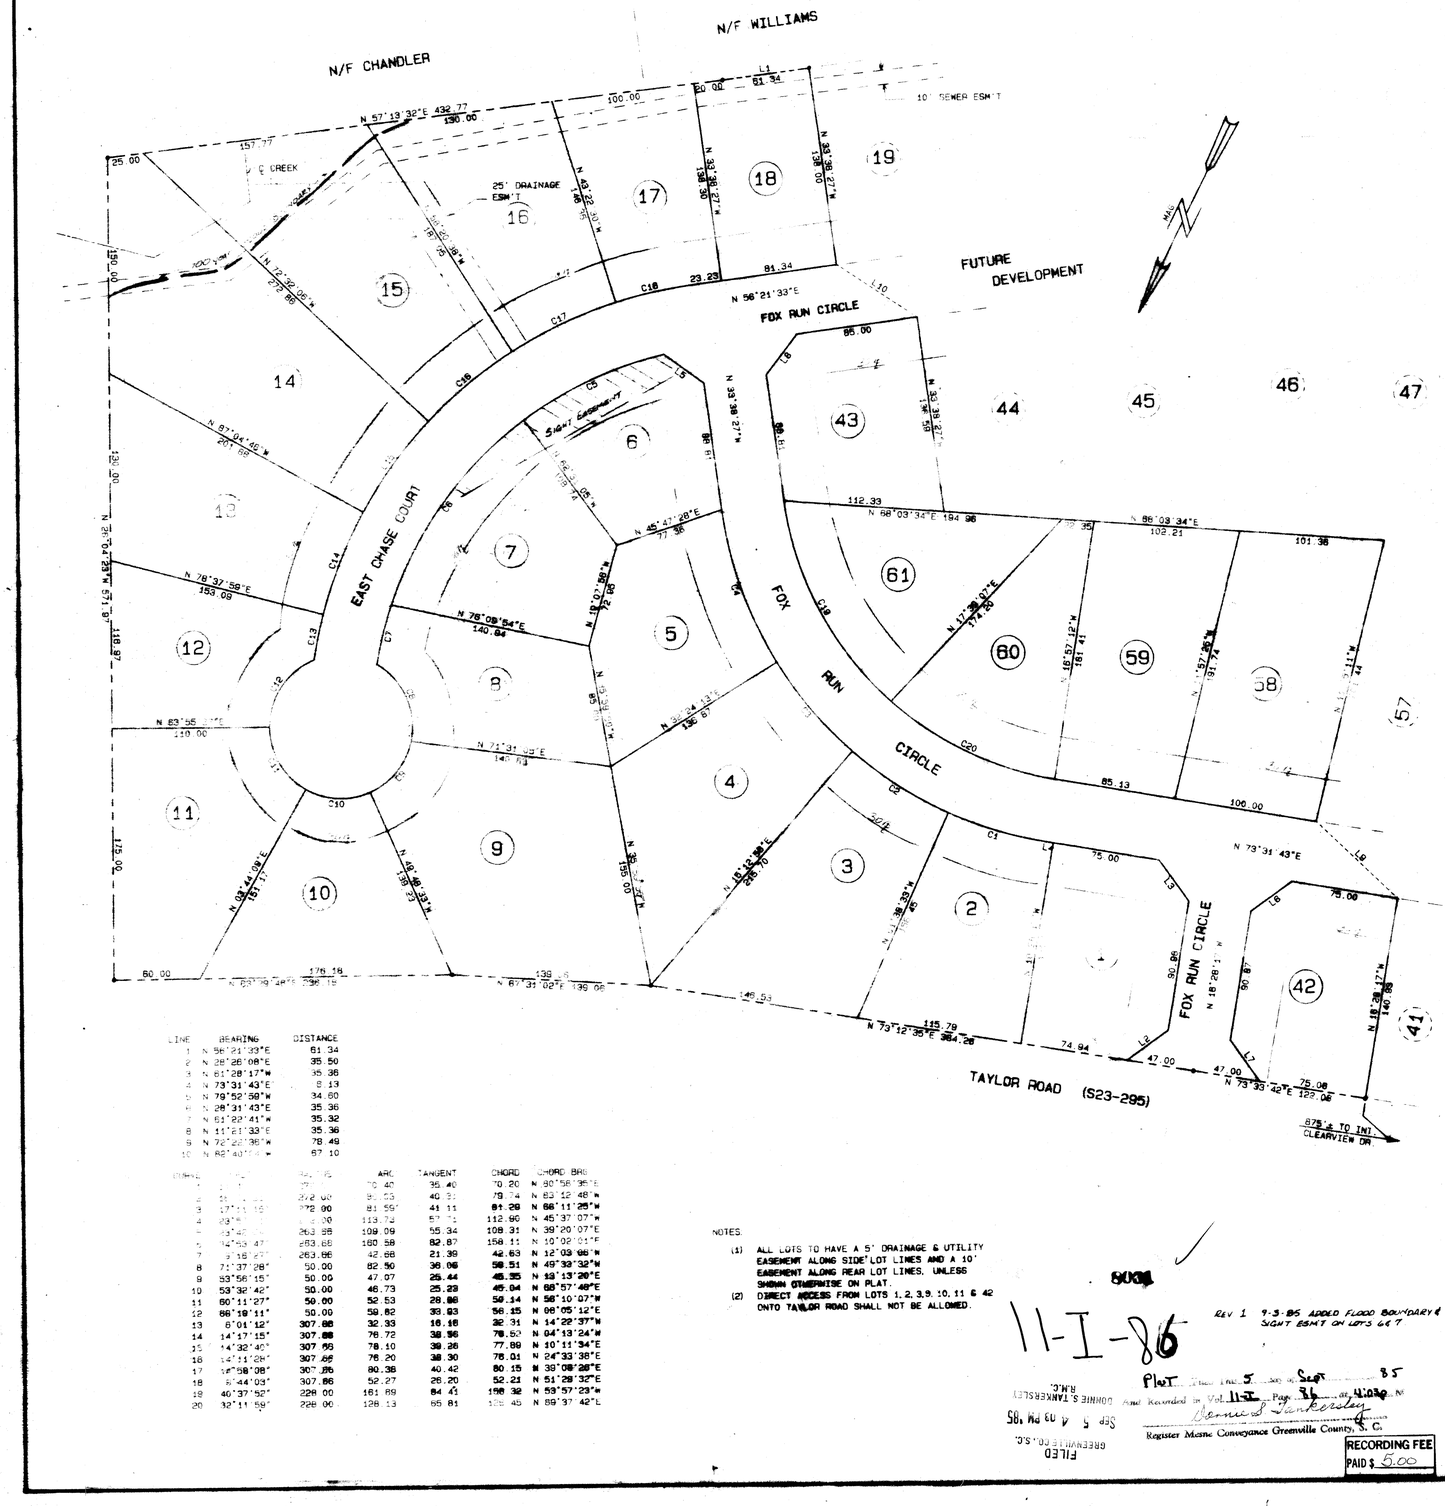
N/F WILLIAMS
N/F CHANDLER
10' SEWER ESM'T
25' DRAINAGE ESM'T
℄ CREEK
FUTURE DEVELOPMENT
FOX RUN CIRCLE
EAST CHASE COURT
FOX RUN CIRCLE
CIRCLE
TAYLOR ROAD (S23-295)
N 57°19'32"E 432.77
130.00
100.00
20.00
81.34
157.77
N 72°22'08"W 27.88
N 56°21'33"E
81.34
23.23
112.33
N 88°03'34"E 184.98
N 86°03'34"E 102.21
101.38
85.00
N 33°38'27"W 136.00
N 45°47'28"E 77.96
N 76°08'54"E 140.84
N 71°31'08"E 140.84
N 83°55'
110.00
N 78°37'58"E 153.08
N 87°04'46"W 20.68
N 24°04'23"W 57.87
118.87
130.00
175.00
60.00
176.18
N 83°39'28"E 196.18
139.18
N 67°31'02"E 195.08
146.53
N 73°12'35"E 364.28
115.79
74.94
47.00
75.00
N 79°31'43"E
N 18°28'17"W 140.88
N 79°33'42"E 122.08
875'± TO INT CLEARVIEW DR
N 17°28'12"E 174.26
N 16°57'12"W 181.41
N 17°57'26"E 91.74
N 18°05'11"W 91.44
N 18°28'17"W 140.88
N 18°28'17"W 90.87
90.87
80.86
